

USDA-FOREST SERVICE

Index  
File No. G-25

CORNER RECORD (SEARCH)

(Ref. FSM 7151.4)

Tract or  
Survey No. \_\_\_\_\_ Cor.  
No. \_\_\_\_\_


T 4 N \_\_\_\_\_ R. 37 E

R.D. Walla Walla County Umatilla

Merid. Willamette

N.F. Umatilla State Oregon

CORNER DIAGRAM

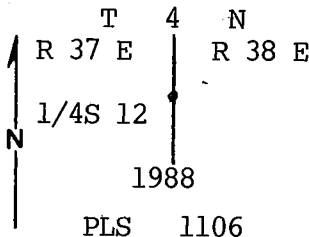

DESCRIBE CORNER MONUMENT FOUND

Found a basalt stone 14x7x5", setting upright in mound of stone and marked 1/4 on W. face ("1/4" marks are not very distinct), from which:

DESCRIBE BEARING TREES, OR OTHER OFFICIAL ACCESSORIES FOUND

A 42" ponderosa pine brs S76 E, 188.9' with scribes visible on partially healed blaze. (OBT)

PHOTO IDENTIFICATION DATA

Photo No. 880-50  
Filed At. UMATILLA S.O.  
Object Ident. Trees  
Ident. By W. Wells  
*Signature*

DESCRIBE CORNER LOCATION RELATIVE TO NEAR-BY FEATURES, ALSO HOW TO REACH CORNER

Corner is located on an open hillside about 17' East of old, down N - S fence and about 500' N of trail up South Fork of Walla Walla River.

PLANE COORDINATE POSITION DATA

State \_\_\_\_\_ Zone \_\_\_\_\_  
X \_\_\_\_\_  
Y \_\_\_\_\_  
Estab. By \_\_\_\_\_  
*Agency*

*Signature*  
Will. R. Wells

Title \_\_\_\_\_ Division \_\_\_\_\_  
Land Surveyor

Headquarters \_\_\_\_\_ Date \_\_\_\_\_  
Pendleton, Or. 8-24-88

FS-7100-52 (3/68)

### CORNER RECORD (PERPETUATION)

**MONUMENT: DESCRIBE NEW MONUMENT SET, OR WORK DONE TO PRESERVE EXISTING MONUMENT**

At position of found corner stone...

Set  $2\frac{1}{2}$ " aluminum cap on  $2\frac{1}{2}$ " x 30" aluminum pipe 12" in ground to bedrock & surrounded with mound of earth & stone. Set 6' fence post South of corner with sign 54-4 attached. Cap marked as shown in corner diagram. Buried corner stone in mound.  
Compass declination  $19^{\circ}$  East.

**ACCESSORIES : DESCRIBE NEW BT'S WITNESS OBJECTS ETC. ESTABLISHED, OR WORK DONE TO PRESERVE EXISTING EVIDENCE**

New bearing trees established:

A 12" ponderosa pine brs  $S24\frac{1}{2}^{\circ}W$ , 125.2' scribed 1/4S12 BT.

A 14" ponderosa pine brs  $S87\frac{1}{2}^{\circ}W$ , 65.5' scribed 1/4S12 BT.

New bearing trees have a brass washer stamped PLS 1106 nailed to face of blaze. Attached sign 54-3 & 54-4 to each BT and painted face of blaze & 6" red band around each BT.

Work Done By. W.R.Wells Title Land Surveyor Date 8-24-88 State Registration No. ORLS 1106  
or Agency

Certified Cor. Record Prepared ? Yes XXXX Filed At: County Surveyor

Date

REMARKS

Index File No. G-25 T. 4 N R. 37 E


WM.

Tract or Surv. No.

Cor.

Index File No. G - 25 CORNER RECORD (SEARCH) Tract or Survey No. \_\_\_\_\_ Cor. No. 1/4 Cor  
 (Ref. FSM 7151.4)  
 T<sub>6</sub> 4N R. ~~38E~~ 37E R.D. Walla Walla County Umatilla  
 Merid. Willamette N.F. Umatilla State Oregon

CORNER DIAGRAM

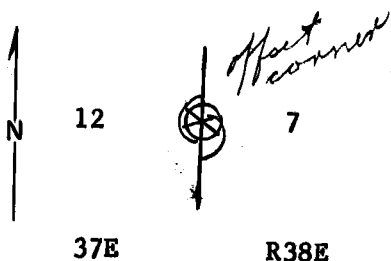

DESCRIBE CORNER MONUMENT FOUND

$\frac{1}{4}$  12/0  
 P  
 L  
 4

DESCRIBE BEARING TREES OR OTHER OFFICIAL ACCESSORIES FOUND

40" pine  
 $\frac{1}{2}$  S legible

PHOTO IDENTIFICATION DATA

Photo No. \_\_\_\_\_  
 Filed At. \_\_\_\_\_  
 Object Ident. \_\_\_\_\_  
 Ident. By \_\_\_\_\_  
 Signature \_\_\_\_\_

DESCRIBE CORNER LOCATION RELATIVE TO NEAR-BY FEATURES, ALSO HOW TO REACH CORNER

PLANE COORDINATE POSITION DATA

State \_\_\_\_\_ Zone \_\_\_\_\_  
 X \_\_\_\_\_  
 Y \_\_\_\_\_  
 Estab. By \_\_\_\_\_  
 Agency \_\_\_\_\_

Signature  
 John Blom

Title  
 Engr Tech

Division  
 Engr

Headquarters  
 Walla Walla

Date  
 4/1/71

7100-52 (3/68)

CORNER RECORD (PERPETUATION)

MONUMENT: DESCRIBE NEW MONUMENT SET, OR WORK DONE TO PRESERVE EXISTING MONUMENT

ACCESSORIES : DESCRIBE NEW BT's WITNESS OBJECTS ETC, ESTABLISHED, OR WORK DONE TO PRESERVE EXISTING EVIDENCE

Work Done By \_\_\_\_\_ Title \_\_\_\_\_ Date \_\_\_\_\_ State Registration No. or Agency \_\_\_\_\_  
Certified Cor. Record Prepared ? Yes No Filed At: \_\_\_\_\_ Date \_\_\_\_\_

REMARKS

Index File No. G-25T. R. M. Tract or Surv. No. Cor. 13