

CERTIFIED RECORD OF LAND CORNER MONUMENTATION

HISTORY OF ORIGINAL CORNER ESTABLISHMENT:

Originally established by George S. Pershin, U.S. Deputy Surveyor, under Contract No. 332, dated July 29, 1879. Surveyor record states:


Set Fir post on Northwest slope for corner for 1/4 Sec. Cor. from which:

- A fir, 10 ins. dia. bears N50°E, 45 lks. dist.
- A fir, 6 ins. dia. bears S28°W, 35 lks. dist.

In 1977, James Hambleton, in Survey Number N-65 indicates that he find the original GLO corner.

In Survey Number 93-64-C, William Wells find a wagon axle skein in a mound of stone, from which a rotten stump with axe marks and scribing bears S30°W, 23.4 ft. Monumentation record states that he replaces it with a 1 1/2" x 30" iron pipe with a 2" brass cap, 25 inches in the ground from which:

- A 10 inch fir bears S85°W, 10.0'
- A 14 inch fir bears N18°W, 24.1'
- A 7 inch fir bears S88°E, 13.6'
- A 8 inch fir bears S14°E, 22.2'.

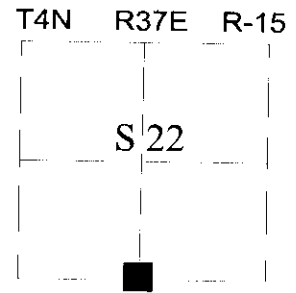

DESCRIPTION OF CORNER EVIDENCE FOUND:

Found a 2 1/2" brass cap on a 1 1/2" iron pipe 3" above ground marked as shown below from which:

- A stump bears East, a distance of 13.6 feet, scribe marks visible.
- An 8 inch White Fir bears South 9° East, a distance of 22.2 feet, alive and vigorous with healed blaze.
- A 13 inch White Fir bears South 80° West, a distance of 10.3 feet, alive and vigorous with healed blaze.
- A 19 inch White Fir bears North 18° West, a distance of 24.1 feet, alive and vigorous with scribe marks visible on a partially healed blaze.

DESCRIPTION OF MONUMENT AND ACCESSORIES I ESTABLISHED

TO PERPETUATE THE ORIGINAL LOCATION OF THIS CORNER:

NEW BEARING TREES:


A 12 inch White Fir bears North 23° East, a distance of 22.60 feet, marked 1/4 S22 BT.

I hereby certify that the corner was perpetuated on October 23, 2013.

REGISTERED
PROFESSIONAL
LAND SURVEYOR

[Signature]
OREGON
June 2, 2010
JEFFERY S. HSU
83571

Renewal Date: June 30, 2015

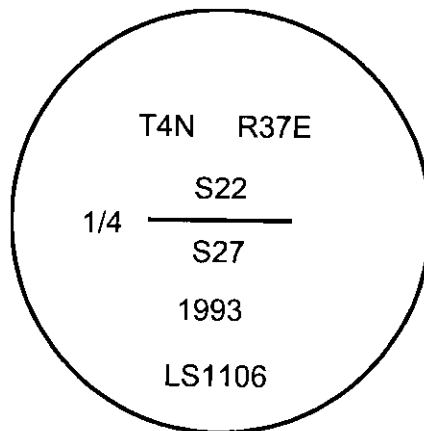

I used a steel tape and magnetic compass in the establishment of the new accessories. I use 16° East declination. The distance to the new bearing tree is to a 60d spike driven into the right side of the root crown of the bearing tree.

RECEIVED BY

Umatilla County Surveyor

Date: 11/6/2013

Rec'd By: [Signature]

No.: 13-5331-B