

CERTIFIED RECORD OF LAND CORNER MONUMENTATION


HISTORY OF ORIGINAL CORNER ESTABLISHED:

Corner not previously established

T 4 N R 37 E R-18

DESCRIPTION OF CORNER EVIDENCE FOUND:

None found

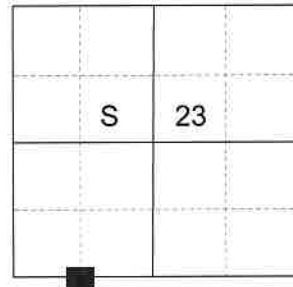

DESCRIPTION OF MONUMENT AND ACCESSORIES I ESTABLISHED TO MONUMENT THE ORIGINAL LOCATION OF THIS CORNER:

At position determined by survey, I set a 5/8"x 30" iron pin, 26" in the ground, with a 2 1/2" aluminum cap, marked as shown below, in a collar of stone 2 ft. diam., from which:

NEW BEARING OBJECTS:


A 7" Douglas Fir bears North 32° East, a dist. of 29.95 ft., marked W 1/16 S23 BT
A 30" Douglas Fir bears South 30° East, a dist. 44.55 ft., marked W 1/16 S23 BT

Set a steel fence post approx. .5 ft. West
Falls in East/West fence line.

I hereby certify that the corner was monumented on October 27, 2021.
Witness: Kyle A. Tucker, Emmitt C. Ambert



Renewal Date: June 30, 2023

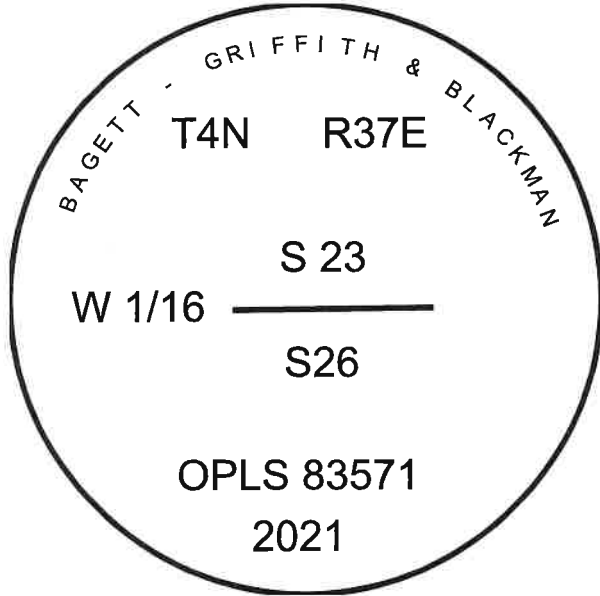

I used a steel tape and magnetic compass in the establishment of the new accessories. I used 14° East declination, the distances are to a 60d spike driven into the right side of the root crown of the bearing trees. A brass washer marked OPLS 83571 is attached to the BT blaze of the new bearing trees.