


CERTIFIED RECORD OF LAND CORNER MONUMENTATION

**HISTORY OF ORIGINAL CORNER ESTABLISHED:**

Corner not previously established.

T 4 N R 37 E R-20

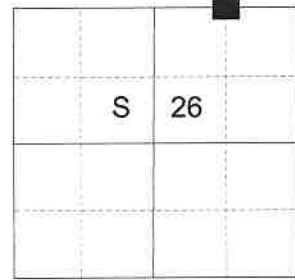

**DESCRIPTION OF CORNER EVIDENCE FOUND:**

None.

**DESCRIPTION OF MONUMENT AND ACCESSORIES I ESTABLISHED TO MONUMENT THE ORIGINAL LOCATION OF THIS CORNER:**

At position determined by survey, I set a 5/8" x 30" iron pin, 10" in the ground, with a 2 1/2" aluminum cap, marked as shown below and in a 3 ft. diam. mound of stone at base to within 4" of the cap, from which:

**NEW BEARING OBJECTS:**


A 30' x 10' x 2' rock outcrop bears North 16°19' East, a distance of 25.00 feet, chiseled X BO in center.  
A 2' x 2' x 4' rock pinnacle bears South 41°31' West, a distance of 116.05 feet, marked X BO on Northeast face

Set steel fencepost 5 feet Southeasterly.

Falls approx. 10' East of North/South running ridge top forest road.

I hereby certify that the corner was monumented on October 9, 2024.

Witnesses: Kyle Tucker

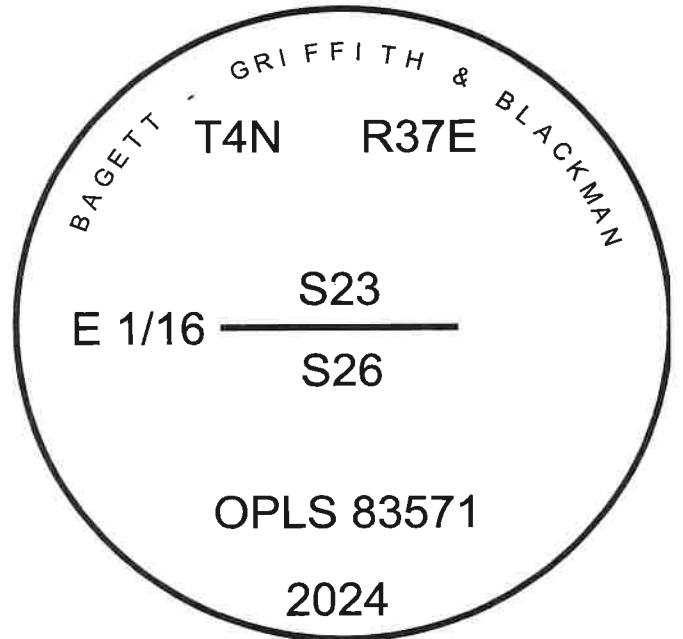

REGISTERED  
PROFESSIONAL  
LAND SURVEYOR

OREGON  
June 2, 2010  
JEFFREY S. HSU  
83571

Renewal Date: June 30, 2025

I use a Leica GS18 with RTK in the establishment of the new bearing objects. Distances and bearings are measured to the center of the chiseled X. Basis of Bearing is as per Survey filed concurrently.

24-104-8