

CERTIFIED RECORD OF LAND CORNER MONUMENTATION

History of original corner establishment:

Original corner set by William Odell, under GLO contract 114, approved July 2, 1866.

Record states:

Set post corner for 1/4 section.

from which:

A fir 18 in diam. bears North 5 lks.

A fir 20 in diam. bears S48°E 11 lks.

Subsequent Monumentation:

In 1969 Don Staebler found a 2" pipe and scribed 2 new BT's .

A 12" tamarack bears N26°E, 25.7 ft.

A 14" fir bears S47°E, 43.7 ft.

Corner remonumented by William R. Wells, per CS 93-064-C.

Record states:

Set a 1 1/2" x 30" iron pipe with a 2 1/2" brass cap, 24" in the ground, at the location of the 2" pipe. There were no rocks available for a rock mound.

New Accessories:


A 16" spruce brs. N.3°E. 19.4 ft. marked 1/4 S20 BT.

A 9" fir brs. N.72 1/2°E. 41.1 ft. marked 1/4 S20 BT.

A 14" fir brs. S.14°E. 39.7 ft. marked 1/4 S29 BT.

A 8" spruce brs. S.41°W. 30.6 ft. marked 1/4 S29 BT.

A steel post with Land Survey Marker sign attached brs. N. 3.2 ft.

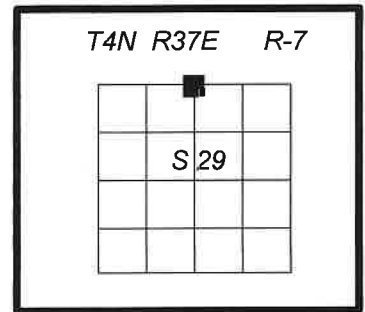

Description of corner evidence found:


Found a 2 1/2 inch brass cap on a 1 1/2 inch G.I.P., mkd. as shown, under a down tree.

From which:

A 24 inch cut spruce stump with "29" visible on cut open blaze, bears S41°W 30.6 ft.

A bent steel t-post with Witness sign fell North 0.5 feet of monument.

All other bearing trees were not found. There has been heavy logging over the years, and logging is currently taking place.

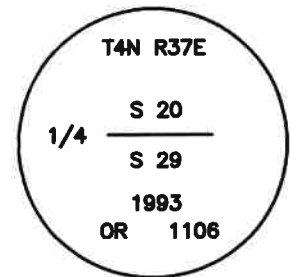

Description of monument and accessories I established to perpetuate original location of this corner:

Down tree was cut and removed from monument. Straightened and reset steel T-post North 0.5 feet of monument.

New accessories:

A 7 inch Douglas Fir mkd. 1/4 S20 BT, bears N36°E, 39.98 feet to a 3/4 inch brass tag mkd: LS 91201 in right side center,.

A 7 inch spruce mkd. 1/4 S29 BT, bears S80°E, 32.74 feet to a 3/4 inch brass tag mkd: LS 91201 in right side center.

A 6 inch white fir mkd. X BT on single blaze, bears S69°W, 12.60 feet to a 3/4 inch brass tag mkd: LS 91201 in right side center.

A 10 inch Douglas Fir mkd. 1/4 S20 BT, bears N43°W, 16.55 feet to a 3/4 inch brass tag mkd: LS 91201 in right side center.

CORS 2011 geographic position:

Lat. 45°48'06.144" N

Long. 118°13'20.104" W

I hereby certify that the corner accessories taken as described, using a hand compass and steel chain on June 5, 2024.

Witness: David Quittschreiber

REGISTERED
PROFESSIONAL
LAND SURVEYOR

OREGON
MAY 9, 2017
KRISTINA POWELL
91201

EXPIRES 12-31-24