


CERTIFIED RECORD OF LAND CORNER MONUMENTATION

HISTORY OF ORIGINAL CORNER ESTABLISHED:

Corner previously established by James Hambleton in Survey N-65-B dated 2-15-77. Umatilla County Survey Record shows Hambleton setting a 5/8" x 30" iron pin.

T 4 N R 37 E S-14

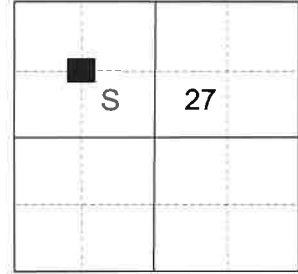

DESCRIPTION OF CORNER EVIDENCE FOUND:

Found a 5/8" iron pin with crumbling yellow plastic cap marked "LS 645", with steel fence post and misc. metal markers on West/Northwest side of pin.

SEE SURVEY FOR MANULIFE FILED AUGUST 2022

DESCRIPTION OF MONUMENT AND ACCESSORIES I ESTABLISHED TO PERPETUATE THE ORIGINAL LOCATION OF THIS CORNER:

At position of found pin, I add a 2 1/2" aluminum cap, marked as shown, to the iron pin, from which:


NEW BEARING OBJECTS:

An 8" Spruce bears South 84° East a dist. of 5.15 ft., marked NW 1/16 S27 BT.
A 4" Spruce bears South 26° West a dist. of 16.60 ft., marked NW 1/16 S27 BT.

Found steel fence post approx. 1 foot North

I hereby certify that the corner was perpetuated on July 27, 2022.

Witness: Kyle Tucker, Dan Drum

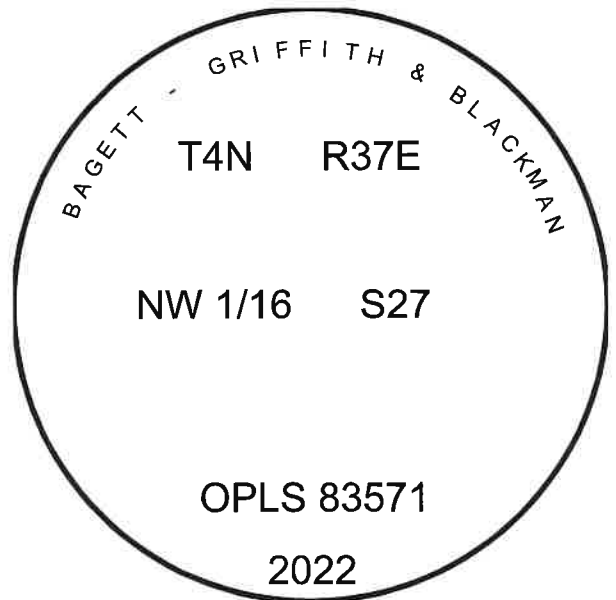

Renewal Date: June 30, 2023

I used a steel tape and magnetic compass in the establishment of the new accessories. I used 14° East declination, the distances are to a 60d spike driven into the right side of the root crown of the bearing trees. A brass washer marked OPLS 83571 is attached to the BT blaze of the new bearing trees.