


CERTIFIED RECORD OF LAND CORNER MONUMENTATION

HISTORY OF ORIGINAL CORNER ESTABLISHED:

Corner not previously established.

T 4 N R 37 E S-20

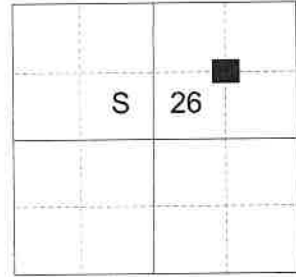

DESCRIPTION OF CORNER EVIDENCE FOUND:

None.

DESCRIPTION OF MONUMENT AND ACCESSORIES I ESTABLISHED TO MONUMENT THE ORIGINAL LOCATION OF THIS CORNER:

At position determined by survey, I set a 5/8" x 30" iron pin, 28" in the ground, with a 2 1/2" aluminum cap, marked as shown below, in a 2 ft. diam. collar of stone, from which:

NEW BEARING OBJECTS:


A 9" diam. Douglas Fir bears North 62° East, a distance of 21.40 feet, marked NE 1/16 S26 BT.
A 19" Douglas Fir bears South 38° East, a distance of 19.20 feet, marked NE 1/16 S26 BT.

Set steel fencepost 0.5 feet East.

Falls approx. 40 ft. downslope of forest road.

I hereby certify that the corner was monumented on October 9, 2024.

Witnesses: Kyle Tucker

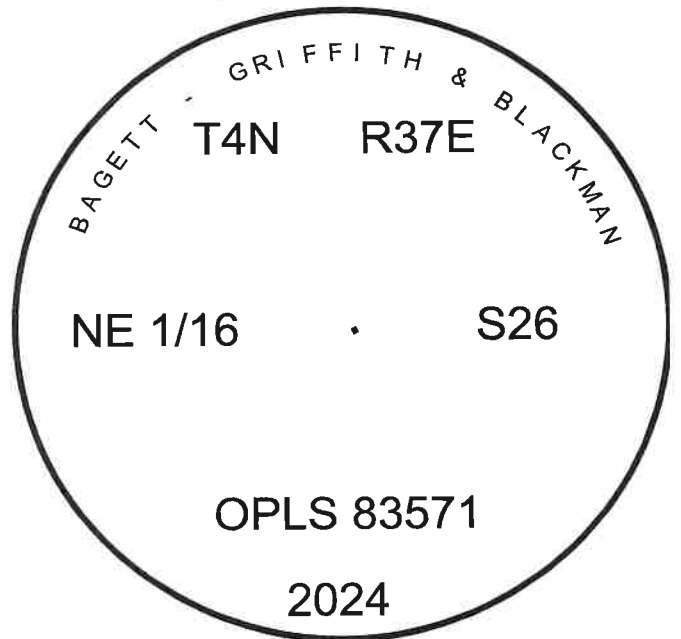

REGISTERED
PROFESSIONAL
LAND SURVEYOR

OREGON
June 2, 2010
JEFFREY S. HSU
83571

Renewal Date: June 30, 2025

I use a Leica GS18 with RTK in the establishment of the new bearing objects. Distances and bearings are measured to the center of the chiseled X. Basis of Bearing is as per Survey filed concurrently.

24-104-8