


CERTIFIED RECORD OF LAND CORNER MONUMENTATION

HISTORY OF ORIGINAL CORNER ESTABLISHED:

Corner not previously established.


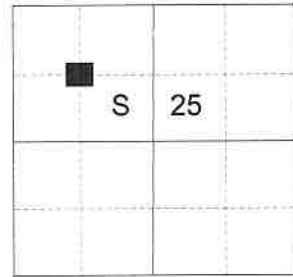

DESCRIPTION OF CORNER EVIDENCE FOUND:

None.

DESCRIPTION OF MONUMENT AND ACCESSORIES I ESTABLISHED TO MONUMENT THE ORIGINAL LOCATION OF THIS CORNER:

At position determined by survey, I set a 5/8" x 30" iron pin, 28" in the ground, with a 2 1/2" aluminum cap, marked as shown below, from which:

NEW BEARING OBJECTS:


A 3" diam. Douglas Fir bears North, a distance of 14.70 feet, marked X BT.
A 6" Douglas Fir bears South 63° West, a distance of 36.40 feet, marked NW 1/16 S25 BT.

Set steel fencepost 1 foot East.

Falls on top edge of cut bank of North/South running forest road.

I hereby certify that the corner was monumented on October 9, 2024.

Witnesses: Kyle Tucker

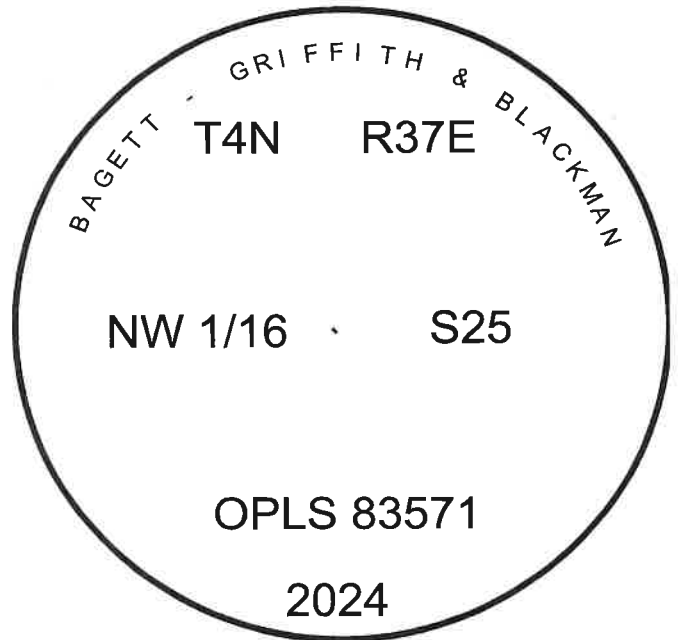

Renewal Date: June 30, 2025

I use a tape and compass in the establishment of the new bearing objects. I use 14° East declination. Bearings are measured to a brass washer labeled "OPLS 83571" in the BT blaze at the base of the tree. Distances are to a 60D nail in the right side of the base of the center of the tree.

24-104-B