


**CERTIFIED RECORD OF LAND CORNER MONUMENTATION**

**History of original corner establishment:**

N/A

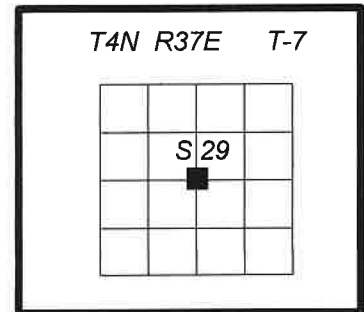

**Description of corner evidence found:**

N/A

**Description of monument and accessories I established to perpetuate original location of this corner:**

At the intersection point, I set a 3 1/4 inch diameter aluminum cap on 2 1/2 inch aluminum pipe, with DEEP-1 magnet at base, 6 inches above ground with rock collar, mkd: as shown.

From which:

A 5/8 x 30 inch iron rod with light blue plastic cap mkd: WALLOWA ASSOCIATES, bears N71°05'37"E, 45.03 feet.

A 5/8 x 30 inch iron rod with light blue plastic cap mkd: WALLOWA ASSOCIATES, bears S87°21'09"E, 16.45 feet.

A 5/8 x 30 inch iron rod with light blue plastic cap mkd: WALLOWA ASSOCIATES, bears S2°28'55"W, 32.83 feet.

A 5/8 x 30 inch iron rod with light blue plastic cap mkd: WALLOWA ASSOCIATES, bears N10°12'47"W, 40.91 feet.

A 6-foot tall steel T-post was set 0.5 feet NE of monument.

CORS 2011 geographic position:

Lat. 45°47'40.585" N

Long. 118°13'19.850" W

I hereby certify that the corner was monumented and accessories taken as described, using GPS RTK on June 25, 2024.

Witness: David Quittschreiber and Shar Quittschreiber



REGISTERED  
PROFESSIONAL  
LAND SURVEYOR

OREGON  
MAY 9, 2017  
**KRISTINA POWELL**  
91201

EXPIRES 12-31-24