


**CERTIFIED RECORD OF LAND CORNER MONUMENTATION**

**HISTORY OF ORIGINAL CORNER ESTABLISHED:**

Corner not previously established.

T 4 N R 37 E U-13

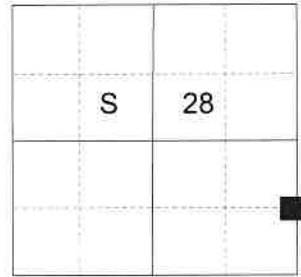

**DESCRIPTION OF CORNER EVIDENCE FOUND:**

Found a 2' diam. mound of stone painted yellow with a 6" long nail wrapped in old pink flagging in the middle. Nail falls 0.18 West of surveyed position. Approx. 50 year old blaze lines run North and West from corner.

SEE SURVEY FOR HANCOCK FOREST MANAGEMENT DATED AUG 2020

**DESCRIPTION OF MONUMENT AND ACCESSORIES I ESTABLISHED TO MONUMENT THE ORIGINAL LOCATION OF THIS CORNER:**

At position by survey, I set a 5/8" x 30" iron pin, 29" in the ground with 2 1/2" aluminum cap marked as shown below, in a 2' diam. mound of stone from which:


**NEW BEARING OBJECTS:**

A 26" White Fir bears North 60° East, a dist. of 12.50 ft., marked S 1/16 S27 BT (tree also has BC Loc. tag).  
A 6" White Fir bears North 64° West, a dist. of 20.45 ft., marked S 1/16 S28 BT.

Set steel fence post approx. 1 ft. South.

I hereby certify that the corner was monumented on August 19, 2020.

Witness: Kyle A. Tucker

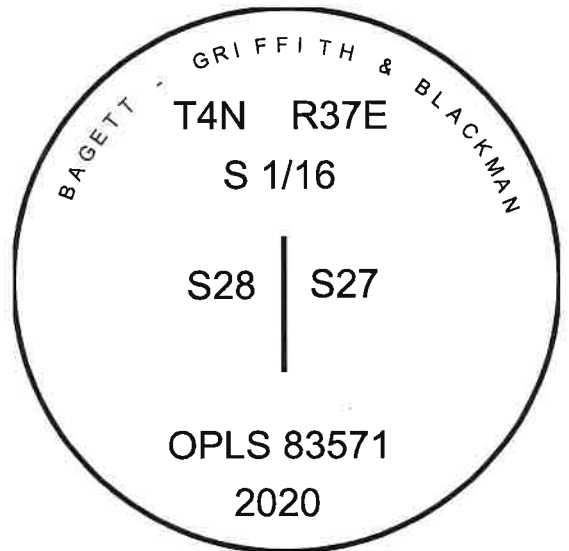

Renewal Date: June 30, 2021

I used a steel tape and magnetic compass in the establishment of the new accessories. I used 14° East declination, the distance is to a 60d spike driven into the right side of the root crown of the bearing tree. A brass washer marked OPLS 83571 is attached to the BT blaze of the new bearing tree.