


CERTIFIED RECORD OF LAND CORNER MONUMENTATION

HISTORY OF ORIGINAL CORNER ESTABLISHMENT:

No history of this corner being set was found

DESCRIPTION OF CORNER EVIDENCE FOUND:

Nothing found

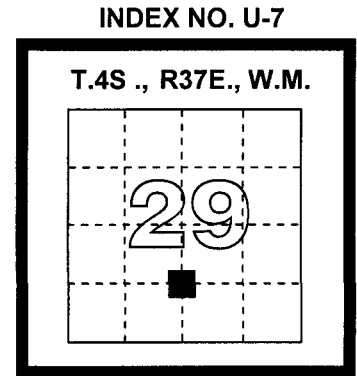

DIAGRAM

DESCRIPTION OF MONUMENT AND ACCESSORIES ESTABLISHED TO PERPETUATE THE LOCATION OF THIS RECORD MONUMENT:

Set a 5/8" x 30" rebar with a 2" aluminum cap stamped as shown


From which:

A 5/8" x 30" iron rebar with 1 1/2" dia. Aluminum cap marked: "APA WA43411 OR87604 RM" bears N.87°57'E., 61.00';

A 1/2" iron rod bears N.02°02'W., 43.27';

A 1/2" iron rod bears S.01°55'E., 76.85'

Note: bearings shown based on geodetic north per gps observations at project site.

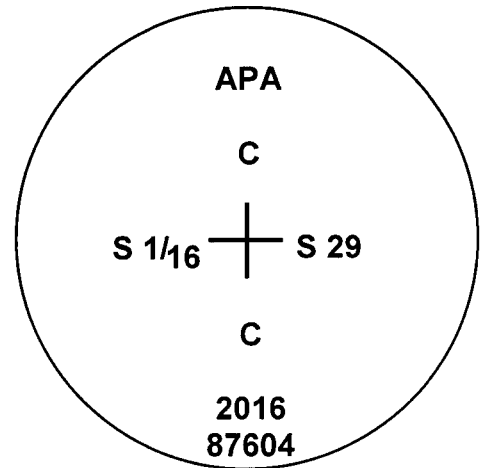

REGISTERED
PROFESSIONAL
LAND SURVEYOR

E. J. Green
OREGON
MAY 14, 2013
ERIK J. GREEN
87604 PLS

RENEWS: 6/30/17

RECEIVED BY

Umatilla County Surveyor

Date: 05/03/2016

Rec'd By: *m. Kellard*

No.: 16-056-13

I hereby certify that the above corner position was Perpetuated as hereon described in april, 2016.

Witnesses: Thomas Boshart