


CERTIFIED RECORD OF LAND CORNER MONUMENTATION

HISTORY OF ORIGINAL CORNER ESTABLISHMENT:

Corner not previously established.

T4N R37E X-12

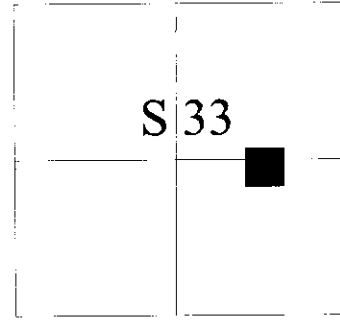

DESCRIPTION OF CORNER EVIDENCE FOUND:

None.

DESCRIPTION OF MONUMENT AND ACCESSORIES I ESTABLISHED

TO PERPETUATE THE ORIGINAL LOCATION OF THIS CORNER:

At position determined by survey, I set a 5/8" x 30" iron pin with a 2 1/2" aluminum cap marked as shown below, 30 inches in the ground, from which:

A 12 inch Larch bears South 64° East, a distance of 12.05 feet, marked CE1/16 S33 BT.

A 15 inch White Fir bears North, a distance of 10.25 feet, marked CE1/16 S33 BT

I set a steel fencepost 1 foot South of the monument.


I hereby certify that the corner was monumented on July 12th, 2013.

Witness: Daniel Inloes

REGISTERED
PROFESSIONAL
LAND SURVEYOR

Jeffery S. Hsu
OREGON
June 2, 2010
JEFFERY S. HSU
83571

Renewal Date: June 30, 2015

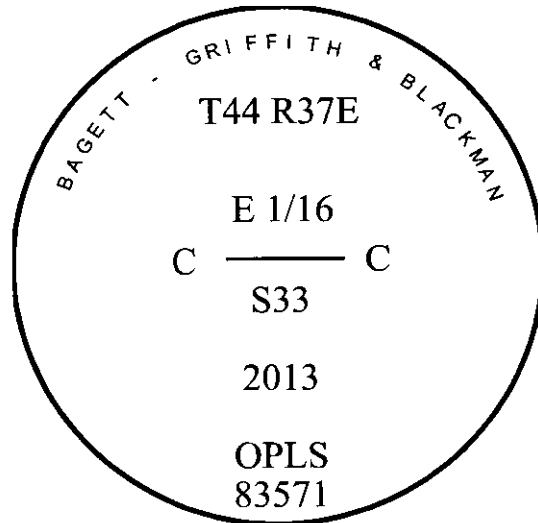

I used a steel tape and magnetic compass in the establishment of the new accessories. I use 16° East declination. The distance to the new bearing trees are to a 60d spike driven into the right side of the root crown of the bearing trees. Attached brass washer marked OPLS 83571 to BT Blaze.

RECEIVED BY
Umatilla County Surveyor
Date: 8/9/2013
Rec'd By: D. Robert
No.: 13-213-C