


CERTIFIED RECORD OF LAND CORNER MONUMENTATION

HISTORY OF ORIGINAL CORNER ESTABLISHED:

Corner not previously established.

T 4 N R 37 E Y-16

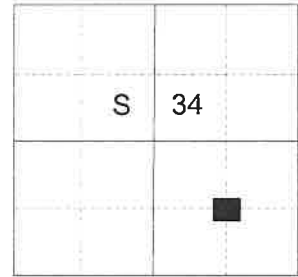

DESCRIPTION OF CORNER EVIDENCE FOUND:

None.

DESCRIPTION OF MONUMENT AND ACCESSORIES I ESTABLISHED TO MONUMENT THE ORIGINAL LOCATION OF THIS CORNER:

At position determined by survey, I set a 5/8" x 30" iron pin, 28" in the ground, with a 2 1/2" aluminum cap, marked as shown below, from which:

NEW BEARING OBJECTS:


A double bole White Fir bears South 28° East, a distance of 7.60 feet, marked SE 1/16 S34 BT.

A 7" Douglas Fir bears South 60° West, a distance of 24.40 feet, marked SE 1/16 S34 BT.

Set steel fence post approx. 0.3 feet Westerly.

I hereby certify that the corner was monumented on October 10, 2024.

Witnesses: Kyle Tucker

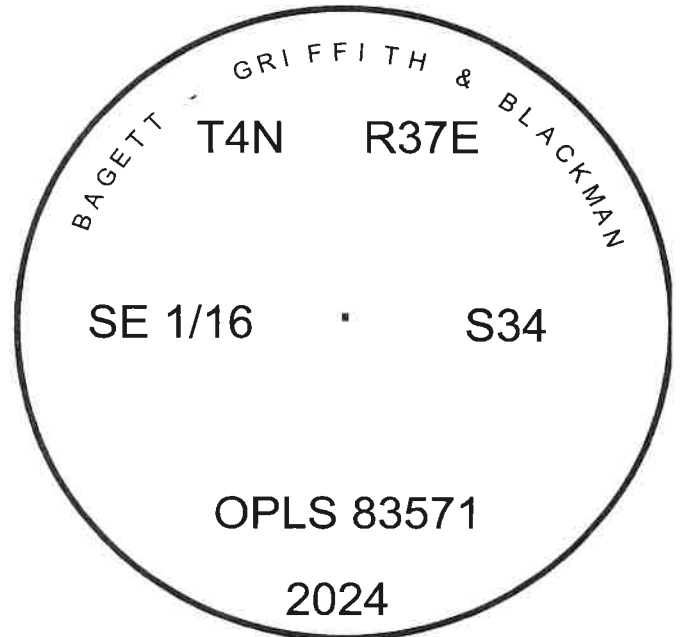

I use a tape and compass in the establishment of the new bearing objects. I use 14° East declination. Bearings are measured to a brass washer labeled "OPLS 83571" in the BT blaze at the base of the tree. Distances are to a 60D nail in the right side of the base of the center of the tree.

Y-16

24-106-C

REGISTERED
PROFESSIONAL
LAND SURVEYOR

OREGON
June 2, 2010

JEFFREY S. HSU
83571

Renewal Date: June 30, 2025