

CERTIFIED RECORD OF LAND CORNER MONUMENTATION

HISTORY OF ORIGINAL CORNER ESTABLISHMENT:

Originally established by George S. Pershin, U.S. Deputy Surveyor, under Contract No. 304, dated September 19, 1878. Surveyor record states:

Set Fir post on level for corner to Section 3, 4, 33, and 34 from which:

- A Tamarack 12" in diameter bears N34°E, 54 links;
- A Tamarack 11" in diameter bears S46°E, 20 links;
- A Fir 18" in diameter bears S52°W, 43 links;
- A Tamarack 14" in diameter bears N62°W, 31 links:

In 1978, Douglas M. Ferguson recovered a 24"x10"x4" stone set 14" in the ground and determined the stone to be a perpetuation of the original corner location as described in corner certificate Q-737.

In 1991, William R. Wells set a 2 1/2" brass cap on an iron pipe at the center position of the original stone and placing the original stone on the east side of the monument from which:

- A scribed 5" western larch bears N9 1/2°E, a distance of 40.2 feet;
- A scribed 12" alpine fir bears S29 1/2°E, a distance of 75.1 feet;
- A scribed 6" white fir bears S35°W, a distance of 14.2 feet;
- A scribed 15" western larch bears N73 1/2°W, a distance of 29.6 feet.

Wells placed bearing object signs on all 4 bearing trees and placed a steel fence post North of the monument with a witness corner sign.

DESCRIPTION OF CORNER EVIDENCE FOUND:

Found a 2" brass cap on a 1" iron pipe 3" above ground level marked as shown below from which:

- A 9" Western larch bears N9°E, a distance of 40.2 feet, alive and vigorous with a healed blaze;
- A 6" stump bears S34°W, a distance of 14.2 feet, with visible scribe marks;
- A 20" Western larch bears N73°W, a distance of 29.6 feet, alive and vigorous with healed blaze;

DESCRIPTION OF MONUMENT AND ACCESSORIES I ESTABLISHED

TO PERPETUATE THE ORIGINAL LOCATION OF THIS CORNER:


NEW BEARING OBJECTS:

- A 4" Western larch bears South 50° East, a distance of 19.00 feet, marked X BT.
- a 6" White fir bears South 40° West, a distance of 33.50 feet, marked X BT.

I hereby certify that the above corner point was perpetuated as heron described on June 26, 2013.

Witness: Daniel O. Inloes

T 4 N R 37 E Z - 13

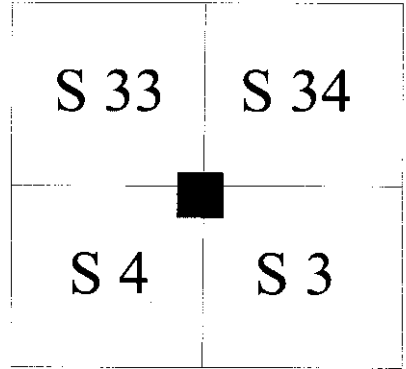


T 3 N R 37 E A - 13

REGISTERED
PROFESSIONAL
LAND SURVEYOR

Jeffery S. Hsu
OREGON
June 2, 2010
JEFFERY S. HSU
83571

Renewal Date: June 30, 2015

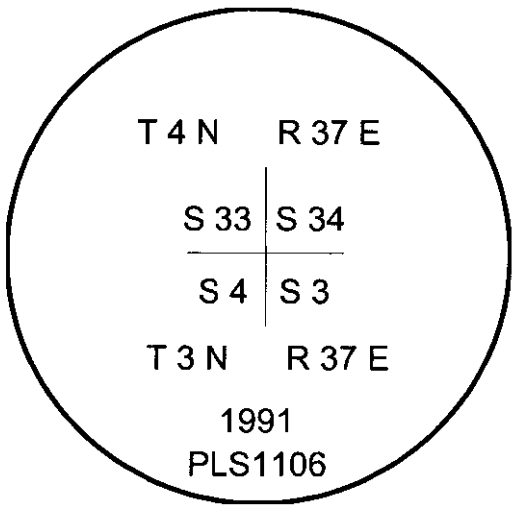

I used a steel tape and magnetic compass in the establishment of the new accessories. I use 16° East declination. The distance to the new SW bearing tree is to a 60d spike driven into the right side of the root crown of the bearing tree. Distance to the SE bearing tree is to a spike driven into the left side. Attached brass washer marked OPLS 83571 to BT Blaze.

RECEIVED BY
Umatilla County Surveyor
Date: 8/9/2013
Rec'd By: D. Robert
No: 13-213-C