

Index File No. C-5

CORNER RECORD (SEARCH)
(Ref. FSM 7151.4)

Tract or Survey No. _____ Cor. No. C-5

T 4 N R. 38 E


R.D. _____ County _____

Merid. _____

N.F. _____ State Oregon

CORNER DIAGRAM

DESCRIBE CORNER MONUMENT FOUND

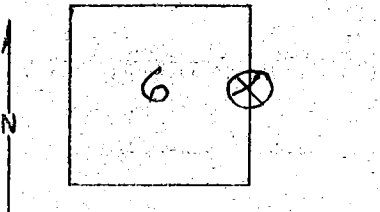

Searched by Boise-Cascade Corp. (La Grande)
Evidence found believed to be acceptable.
~~No card furnished to us.~~

DESCRIBE BEARING TREES OR OTHER OFFICIAL ACCESSORIES FOUND

(Pine B.T. found.) (BCC)

PHOTO IDENTIFICATION DATA

DESCRIBE CORNER LOCATION RELATIVE TO NEAR-BY FEATURES, ALSO HOW TO REACH CORNER

Photo No. _____
Filed At. _____
Object Ident. _____
Ident. By _____
Signature

PLANE COORDINATE POSITION DATA

State _____ Zone _____
X _____
Y _____
Estab. By _____
Agency

Signature TEN (CK-TD)

Title _____ Division _____ Headquarters _____

Date 1-77 (1976) 7100-52-(3/68)

CORNER RECORD (PERPETUATION)

G.P.O. 902-673

MONUMENT: DESCRIBE NEW MONUMENT SET, OR WORK DONE TO PRESERVE EXISTING MONUMENT

9

ACCESSORIES DESCRIBE NEW BT'S WITNESS OBJECTS ETC. ESTABLISHED, OR WORK DONE TO PRESERVE EXISTING EVIDENCE

10

Work Done By _____ Title _____ Date _____ State Registration No. or Agency _____

Certified Cor. Record Prepared? Yes No Filed At _____ Date _____

11

REMARKS

12

Index File No. T R M Tract or Surv. No. Cor.

13