


72

Index File No. E-3 CORNER RECORD (SEARCH) Tract or Survey No. _____ Cor. No. 1/2

T 4 N R. 38 E R.D. Walla Walla County Umatilla

Merid. Wm. N.F. Umatilla State Oregon

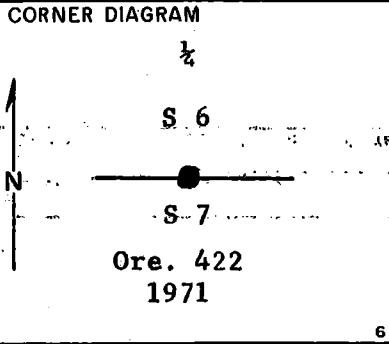

DESCRIBE CORNER MONUMENT FOUND

A basalt stone, scribed 1/2 on one side

This corner has been remonumented. (Found 1976 B.C.C.)

See Back of Card

DESCRIBE BEARING TREES OR OTHER OFFICIAL ACCESSORIES FOUND

A mound of stone and a B.T., 36" pine, bears S 38E
Approx. 200 ft. Dist. with the face partially chopped
out & some scribing visible and legible.

There is a new B.T. See Back of Card

PHOTO IDENTIFICATION DATA

Photo No. _____

Filed At. _____

Object Ident. _____

Ident. By. _____

Signature _____

DESCRIBE CORNER LOCATION RELATIVE TO NEAR-BY FEATURES, ALSO HOW TO REACH CORNER

There are two blazed lines leading North from the
South Fk. of the Walla Walla River Trail to this
corner. The line farthest West is the true line
established by A.J. Lommasson at the same time he
remonumented the North and South 1/2 corner of Sec. #7.
This line divides Sec. 7 into East & West halves.

PLANE COORDINATE POSITION DATA

State _____ Zone _____

X _____

Y _____

Estab. By. _____

Agency _____

Signature J. W. Blom Title ENG. TECH. Division ENGR. Headquarters WALLA WALLA Date 4-17-72

7100-52
REV. 65

CORNER RECORD (PERPETUATION)

MONUMENT. DESCRIBE NEW MONUMENT SET, OR WORK DONE TO PRESERVE EXISTING MONUMENT

2" pipe, 36" long, with bottom flared and a 3" bronze disk brazed to the top, 2 1/4" into the ground. The original basalt stone is set next to the pipe with the original scribed 1/4 visible and legible. The disk is stamped as shown in the corner diagram.

ACCESSORIES : DESCRIBE NEW BT'S WITNESS OBJECTS ETC. ESTABLISHED, OR WORK DONE TO PRESERVE EXISTING EVIDENCE

The new B.T. is a 28" red fir, bearing S 40° W, 7 1/4 ft. dist. marked 1/4 S 7 BT. There are B.T. posters on both B.T.'s. There is a location poster and a yellow attention poster on the new B.T.

Work Done By A. J. Lommasson Title Registered Ore. Land Surveyor Date 6-71 State Registration No. Ore. Lic. #422
or Agency

Certified Cor. Record Prepared Yes No Filed At: Pendleton, Oregon Date 7-29-71

REMARKS

The true line leading to this 1/4 corner leaves the South Fork Trail just west of the lower cabin belonging to Harold Biggs. All buildings belonging to Harold Biggs on this flat are setting on U.S. land.

Index File No. E-3 T. R. M. Tract or Surv. No. Cor.

Index
File No. E-3

CORNER RECORD (SEARCH)

(Ref. FSM 7151.4)

Tract or Survey No. _____ Cor. No. _____

T 4N R. 38 E


R.D. Walla Walla County Umatilla

Merid. Willamette

N.F. Umatilla State Oregon

CORNER DIAGRAM

T 4 N R 38 E

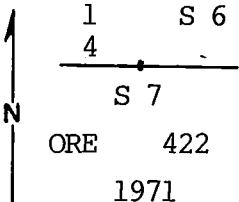

DESCRIBE CORNER MONUMENT FOUND

Found a 15x9x5" basalt stone with "1/4" alongside monument, A 3" brass cap on 2 1/2" galvanized iron pipe protruding 10" from a mound of stone.

DESCRIBE BEARING TREES OR OTHER OFFICIAL ACCESSORIES FOUND

6 A 40" ponderosa pine brs S38°E, 207.8' with scribes visible on opened blaze. (OBT) A 28" douglas fir brs S40°W, 70.8' with healed blaze. (Lommasson BT)

PHOTO IDENTIFICATION DATA

Photo No. 880-49
Filed At. Umatilla S.O.
Object Ident. Trees
Ident. By WR Wells
Signature

DESCRIBE CORNER LOCATION RELATIVE TO NEAR-BY FEATURES, ALSO HOW TO REACH CORNER

7 Corner located at West edge of bare hillside.

PLANE COORDINATE POSITION DATA

State _____ Zone _____
X _____
Y _____
Estab. By _____
Agency

Signature

Willie R. Wells

Title Land Surveyor Division _____

Headquarters Pendleton, Or.

Date 8-12-88 FS-7100-52 (3/68)

CORNER RECORD (PERPETUATION)

MONUMENT: DESCRIBE NEW MONUMENT SET, OR WORK DONE TO PRESERVE EXISTING MONUMENT

Maintained monument by mounding more stone around the monument.
I etched Township and Range on monument with pocket knife.

Compass declination 19⁰ East.

ACCESSORIES : DESCRIBE NEW BT'S WITNESS OBJECTS ETC. ESTABLISHED, OR WORK DONE TO PRESERVE EXISTING EVIDENCE

New bearing trees established:

A 24" douglas fir bears N65⁰W, 171.1' scribed 1/4S6 BT.

New bearing tree has brass washer stamped PLS 1106 nailed to face of blaze. Set steel fence post West of corner and attached sign 54-4. ATTACHED 54-3 AND 54-4 SIGNS TO EACH BEARING TREE AND PAINTED FACE OF BLAZE AND A 6" RED BAND AROUND EACH BEARING TREE.

Work Done By. W.R.Wells Title Land Surveyor Date 8-12-88 State Registration No. ORLS 1106
or Agency

Certified Cor. Record Prepared ? Yes XNXX Filed At: County Surveyor Date

REMARKS

Index File No. E-3 T. 4 N R. 38 E WM. Tract or Surv. No. Cor.