


Index
 File No. H-1
 T 4 N R. 38 E
 Merid. Willamette

CORNER RECORD (SEARCH)

(Ref. FSM 7151.4)

R.D. Walla Walla County Umatilla Tract or Survey No. _____ Cor. No. _____
 N.F. Umatilla State Oregon

CORNER DIAGRAM

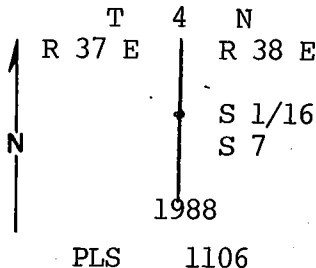

DESCRIBE CORNER MONUMENT FOUND

None. Corner established with this survey.

DESCRIBE BEARING TREES OR OTHER OFFICIAL ACCESSORIES FOUND

None.

PHOTO IDENTIFICATION DATA

Photo No. _____
 Filed At. _____
 Object Ident. _____
 Ident. By _____
Signature

DESCRIBE CORNER LOCATION RELATIVE TO NEAR-BY FEATURES, ALSO HOW TO REACH CORNER

Corner located on timbered North slope about 900' South of the South Fork of the Walla Walla River.

PLANE COORDINATE POSITION DATA

State _____ Zone _____
 X _____
 Y _____
 Estab. By _____
Agency

Signature

Walter R. Wells

Title

Land Surveyor

Division

Headquarters

Pendleton, Or.

Date

8-30-88

FS-7100-52 (3/68)

CORNER RECORD (PERPETUATION)

MONUMENT: DESCRIBE NEW MONUMENT SET, OR WORK DONE TO PRESERVE EXISTING MONUMENT

At position determined by survey...

Set 2½" aluminum cap on 2½" x 30" aluminum pipe 24" in ground to bedrock & surrounded with mound of earth only. Set 6' fence post South of corner with signs 54-9 & 54-2 attached. Cap marked as shown in corner diagram.

Compass declination 19° East.

ACCESSORIES : DESCRIBE NEW BT's WITNESS OBJECTS ETC. ESTABLISHED, OR WORK DONE TO PRESERVE EXISTING EVIDENCE

New bearing trees established:

A 15" douglas fir brs EAST, 40.4' scribed S1/16S7 BT.

A 14" douglas fir brs N35½° E, 19.9' scribed S1/16S7 BT.

New bearing trees have a brass washer stamped PLS 1106 nailed to face of blaze. Attached sign 54-3 & 54-9 to each BT and painted face of blaze & 6" red band around each BT.

Work Done By W.R.Wells Title Land Surveyor Date 8-24-88 State Registration No. ORLS 1106
or Agency

Certified Cor. Record Prepared ? Yes XXX Filed At: County Surveyor

Date

REMARKS

Index File No. H-1

T. 4 N

R. 38 E

WM.

Tract or Surv. No.

Cor.