

Index

File No. J-3

CORNER RECORD (SEARCH)

(Ref. FSM 7151.4)

Tract or

Survey No. _____

Cor.

No. _____

T 4 N R. 38 E

R.D. Walla Walla County Umatilla

Merid. Willamette

N.F. Umatilla State Oregon

CORNER DIAGRAM

T 4 N R 38 E



$\frac{1}{4}$ $\frac{S}{S} \frac{7}{18}$

1988

PLS 1106

DESCRIBE CORNER MONUMENT FOUND

In a mound of stone, found a 18x9x6" basalt stone marked "1/4" on N face. The monument from the 1971 Lommasson survey was found about 50' downhill from the corner stone. Re-established corner position in the hole in mound of stone where the Lommasson monument fell from. From the re-established cor. position... A 15" uprooted douglas fir

DESCRIBE BEARING TREES OR OTHER OFFICIAL ACCESSORIES FOUND

Lommasson's monument is marked;

brs N⁰W, 48.2' with scribes visible (OBT). A 18" douglas fir brs N45°E, 32 .0' with scribes visible on partially healed blaze (L.BT). A 44" douglas fir brs S43°W, 150.0' with scribes visible (L.BT). Lommasson monument is a 2½" x 36" iron pipe with 3" brass cap marked as shown to right...

$\frac{1}{4}$
4
 $\frac{S}{S} \frac{7}{18}$
S 18.
ORE 422
1971

PHOTO IDENTIFICATION DATA

Photo No. 886-50

Filed At. Umatilla S.O.

Object Ident. Trees

Ident. By W.R. Wells

Signature

PLANE COORDINATE POSITION DATA

State _____ Zone _____

X _____

Y _____

Estab. By _____

Agency

DESCRIBE CORNER LOCATION RELATIVE TO NEAR-BY FEATURES, ALSO HOW TO REACH CORNER

Corner located 10' West of the top of a N-S ridge in the rock outcrops.

Signature

W.R. Wells

Title

Land Surveyor

Division

Headquarters

Pendleton, Or.

Date

8-31-88

FS-7100-52 (3/68)

CORNER RECORD (PERPETUATION)

MONUMENT: DESCRIBE NEW MONUMENT SET, OR WORK DONE TO PRESERVE EXISTING MONUMENT

At the reestablished corner position...

Set 2½" aluminum cap on 2½" x 30" aluminum pipe 18" in ground to bedrock & surrounded with mound of earth & stone. Set 6' fence post West of corner with sign 54-4 attached. Cap marked as shown in corner diagram. Placed Lommasson's monument & corner stone in mound.

Compass declination 19° East.

ACCESSORIES : DESCRIBE NEW BT'S WITNESS OBJECTS ETC. ESTABLISHED, OR WORK DONE TO PRESERVE EXISTING EVIDENCE

Painted blazes and a 6" red band around each BT, attached signs 54-3 and 54-4 to each BT.

Work Done By W.R.Wells Title Land Surveyor Date 8-31-88 State Registration No. ORLS 1106
or Agency

Certified Cor. Record Prepared? Yes XXXX Filed At: County Surveyor Date

REMARKS

Index File No. J-3 T. 4 N. R. 38 E. W.M. Tract or Surv. No. Cor.


12
Index File No. J-3
T 4 N R. 38 E
Merid. WM

CORNER RECORD (SEARCH)

Tract or Survey No. _____
Cor. No. _____ Sec. 5

R.D. Walla Walla County Umatilla
N.F. Umatilla State Oregon

CORNER DIAGRAM

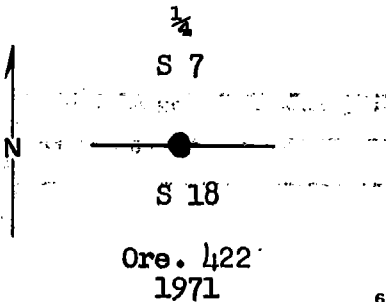

DESCRIBE CORNER MONUMENT FOUND

Basalt stone marked 1/4 on north face just south of a mound of stone. This corner has been remonumented. See back of card.

DESCRIBE BEARING TREES OR OTHER OFFICIAL ACCESSORIES FOUND

A dead, down 20" fir, bears N 7° W, approx. 60 ft. dist, scribed 1/4 S 7 BT.
There are two new bearing trees. See back of card.

PHOTO IDENTIFICATION DATA

Photo No. _____
Filed At. _____
Object Ident. _____
Ident. By _____
Signature

(Revisited 10/4/76 B.C.C. No change)

PLANE COORDINATE POSITION DATA

State _____ Zone _____
X _____
Y _____
Estab. By _____
Agency _____

DESCRIBE CORNER LOCATION RELATIVE TO NEAR-BY FEATURES, ALSO HOW TO REACH CORNER

The corner is right on top of a ridge that descends north into the South Fork of the Walla Walla River.

Signature
J. W. Blom

Title Eng. Teah Division Engr. Headquarters Walla Walla

Date 4-17-72

7100-52
REV. 65

4
[Signature]

CORNER RECORD (PERPETUATION)

MONUMENT. DESCRIBE NEW MONUMENT SET, OR WORK DONE TO PRESERVE EXISTING MONUMENT

2" pipe, 36" long, flared on the bottom with a 3" bronze disk brazed to the top. 20" into the ground. The disk is stamped as shown in the corner diagram

ACCESSORIES : DESCRIBE NEW BT'S WITNESS OBJECTS ETC. ESTABLISHED, OR WORK DONE TO PRESERVE EXISTING EVIDENCE

The two new bearing trees are: A 14" red dir, bears N 45° E, 32 Ft. dist. marked ¼ S 7 BT. A 14" red fir, bears S 43° W, 150 ft. dist. and 75 lower than the corner, marked ¼ S 18 BT. at the base. Both trees are tagged with B.T. posters. The 14" fir also has a location poster attached and the 14" fir also has a USFS warning poster attached.

Work Done By A. J. Lommasson Title Registered Ore. Land Surveyor Date 6-71 State Registration No. or Agency Ore. Lic. #122

Certified Cor. Record Prepared? Yes No Filed At: Pendleton, Oregon Date 7-29-71

REMARKS

Index File No. J-3 T. R. M. Tract or Surv. No. Cor.