


Index  
File No. R 13  
T 4N R. 38E  
Merid. Willamette

**CORNER RECORD (SEARCH)**

(Ref. FSM 7151.4)

Tract or Survey No. \_\_\_\_\_ Cor. No. R 13  
R.D. Walla Walla County Umatilla  
N.F. Umatilla State Oregon

**CORNER DIAGRAM**

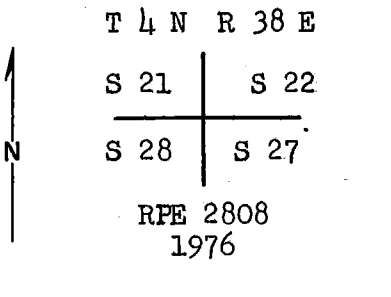

**DESCRIBE CORNER MONUMENT FOUND**

Found a basalt stone 17" x 10" x 6" in place with an X chisled on top point and with 2 notches on the south and 3 notches on the east edges.

**DESCRIBE BEARING TREES OR OTHER OFFICIAL ACCESSORIES FOUND**

A rotten stump bears S 10° E., 82 lks (54.1 ft) dist. for S. 27 BT

A rotten stump bears S 30° W., 52 lks (34.3 ft) dist. for S. 28 BT

No trace of secs. 21 & 22 BT

**PHOTO IDENTIFICATION DATA**

Photo No. \_\_\_\_\_  
Filed At. \_\_\_\_\_  
Object Ident. \_\_\_\_\_  
Ident. By \_\_\_\_\_  
*Signature*

**DESCRIBE CORNER LOCATION RELATIVE TO NEAR-BY FEATURES, ALSO HOW TO REACH CORNER**

S 45 E., 150 feet dist from LUP PI #79 EOP

**PLANE COORDINATE POSITION DATA**

State \_\_\_\_\_ Zone \_\_\_\_\_  
X \_\_\_\_\_  
Y \_\_\_\_\_  
Estab. By \_\_\_\_\_

*James D. Hanley*  
Signature  
James D. Hanley

Title \_\_\_\_\_ Division ORPE 2808 Headquarters \_\_\_\_\_ Date 6/29/76 7100-52 (3/68)

CORNER RECORD (PERPETUATION)

MONUMENT: DESCRIBE NEW MONUMENT SET, OR WORK DONE TO PRESERVE EXISTING MONUMENT

Set a 2 1/2" brass cap on 2" iron pipe 31" long in earth and rock mound with a 6' steel fence post with sign 54-4 attached 4' south of corner.

ACCESSORIES : DESCRIBE NEW BT'S WITNESS OBJECTS ETC. ESTABLISHED, OR WORK DONE TO PRESERVE EXISTING EVIDENCE

A fir 8" dia. bears S 13° W., 30.0 ft. dist. marked T 4 N R 3 8 E S 28 B T  
A fir 8" dia. bears S.59° E., 34.0 ft. dist. marked T 4 N R 3 8 E S 27 B T  
A fir 12" dia. bears N 28° W., 29.5 ft. dist. marked T 4 N R 3 8 E S 21 B T  
A spruce 14" dia . bears N 27° E., 43.8 ft. dist. marked T 4 N R 3 8 E S 22 B T

Each BT has a sign 54-3 attached 6" below a band of red paint and has a brass washer marked RPE 2808 nailed flush with BT blaze

Work Done By. James D. Hanley Title Engineer Date 6/30/76 State Registration No. ORPE 2808  
or Agency  
Certified Cor. Record Prepared ? Yes ~~XL~~ Filed At: Pendleton, Oregon Date 8/ /76

REMARKS

Buried stone on north side of monument