

USDA-FOREST SERVICE

Index

File No. R-157

CORNER RECORD (SEARCH)

(Ref. FSM 7151.4)

Tract or

Survey No. \_\_\_\_\_

Cor.

No. \_\_\_\_\_


T T4N R. R38E

R.D. Walla Walla County Umatilla

Merid. Willamette

N.F. Umatilla State Oregon

CORNER DIAGRAM

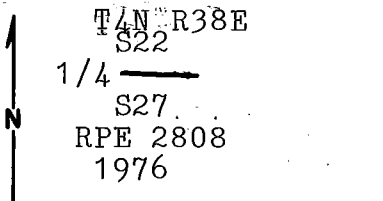

DESCRIBE CORNER MONUMENT FOUND

Found 2 1/2" brass cap on 2 1/2" galv. iron pipe projecting 3" out of a talus rock slide.

DESCRIBE BEARING TREES OR OTHER OFFICIAL ACCESSORIES FOUND

A 12" douglas fir bears S 48° E, 35.5' with healed double blaze. (RPE 2808)  
 A 17" douglas fir bears N 89° W, 60.5' with healed double blaze. (RPE 2808).

PHOTO IDENTIFICATION DATA

Photo No. \_\_\_\_\_

Filed At. \_\_\_\_\_

Object Ident. \_\_\_\_\_

Ident. By \_\_\_\_\_

*Signature*

PLANE COORDINATE POSITION DATA

State \_\_\_\_\_ Zone \_\_\_\_\_

X \_\_\_\_\_

Y \_\_\_\_\_

Estab. By \_\_\_\_\_

*Agency*

DESCRIBE CORNER LOCATION RELATIVE TO NEAR-BY FEATURES, ALSO HOW TO REACH CORNER

Corner is located about 300' East of a drainage flowing Northwest, near the East edge of a talus rockslide. Corner is 100' West of a rimrock 100' high. Walk to corner from the road about 1500' to the Southwest.

*Signature*

*Willis R. Wells*

*Title*

PLS

*Division*

*Headquarters*

Pendleton, OR

*Date*

9/5/91

FS-7100-52 (3/88)

**CORNER RECORD (PERPETUATION)**

**MONUMENT: DESCRIBE NEW MONUMENT SET, OR WORK DONE TO PRESERVE EXISTING MONUMENT**

Maintained existing monument by mounding with stone. Set steel fence post North of corner and attached sign 54-9.

**ACCESSORIES : DESCRIBE NEW BT'S WITNESS OBJECTS ETC. ESTABLISHED, OR WORK DONE TO PRESERVE EXISTING EVIDENCE**

Marked two new bearing trees:

A 8" douglas fir bears N  $47\frac{1}{2}^{\circ}$  W, 57.7' scribed 1/4 S22 BT.

A 14" white fir bears S  $27\frac{1}{2}^{\circ}$  E, 48.0' scribed 1/4 S27 BT.

New bearing trees have a brass washer stamped PLS 1106 nailed to face of blaze. Attached sign 54-3 and 54-9 and painted face of blaze and a 6" red band around each bearing trees.

Work Done By W.R. Wells Title PLS Date 9/5/91 State Registration No. 1106  
or Agency

Certified Cor. Record Prepared ? Yes  No  Filed At: Umatilla Co. Surveyor's Office Date 12/91

REMARKS

Index File No. R-15 T. 4N

R. 38E

M. Will.

Tract or Surv. No.

Cor.

Index  
 File No. R 15  
 T 4 N R. 38 E  
 Merid. Willamette


**CORNER RECORD (SEARCH)**

(Ref. FSM 7151.4)

Tract or  
 Survey No. \_\_\_\_\_ Cor.  
 No. R 15

R.D. Walla Walla County Umatilla  
 N.F. Umatilla State Oregon

CORNER DIAGRAM

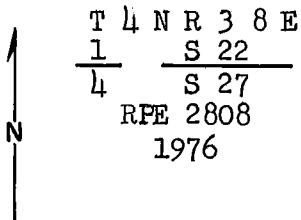

DESCRIBE CORNER MONUMENT FOUND

NONE

DESCRIBE BEARING TREES OR OTHER OFFICIAL ACCESSORIES FOUND

NONE

PHOTO IDENTIFICATION DATA

Photo No. \_\_\_\_\_  
 Filed At. \_\_\_\_\_  
 Object Ident. \_\_\_\_\_  
 Ident. By \_\_\_\_\_  
 Signature \_\_\_\_\_

PLANE COORDINATE POSITION DATA

State \_\_\_\_\_ Zone \_\_\_\_\_  
 X \_\_\_\_\_  
 Y \_\_\_\_\_  
 Estab/By \_\_\_\_\_

DESCRIBE CORNER LOCATION RELATIVE TO NEAR-BY FEATURES, ALSO HOW TO REACH CORNER

Go west from corner common to secs. 22, 23, 26 & 27 to the crest of ridge, course N 65° W m/1 and follow ridge top to vertical rock formation 100 ft. high. Thence follow vertical rock southerly to small talus slide. Corner is 20 feet into talus slide.

Signature James D. Hanley  
 James D. Hanley

Title \_\_\_\_\_ Division ORPE 2808 Headquarters \_\_\_\_\_ Date 6/30/76 7100-52 (3/68)

CORNER RECORD (PERPETUATION)

MONUMENT: DESCRIBE NEW MONUMENT SET, OR WORK DONE TO PRESERVE EXISTING MONUMENT

Set a 2 1/2" brass cap on 2" iron pipe 31" long in rock mound near top edge of talus slide with a 6' steel fence post 6 ft. north with sign 54-4 attached.

ACCESSORIES : DESCRIBE NEW BT'S WITNESS OBJECTS ETC. ESTABLISHED, OR WORK DONE TO PRESERVE EXISTING EVIDENCE

A fir 8" diam bears S 48° E., 35.5 ft. dist. marked 1/4 S 27 BT  
A fir 1 1/4" diam bears N 89° W., 60.5 ft. dist. marked 1/4 S 22 BT

Each BT has a sign 54-3 attached 6" below band of red paint with a brass washer marked RPE 2808 nailed flush with BT blaze.

Work Done By. James D. Hanley Title Engineer Date 7/13/76 State Registration No. ORPE 2808  
or Agency

Certified Cor. Record Prepared ? Yes  Filed At: Pendleton, Oregon Date 8/ /76

REMARKS