

Index
 File No. R 17
 T 4 N R. 38 E
 Merid. Willamette


CORNER RECORD (SEARCH)

(Ref. FSM 7151.4)

Tract or
 Survey No. _____
 Cor. No. R 17

R.D. Walla Walla County Umatilla
 N.F. Umatilla State Oregon

CORNER DIAGRAM

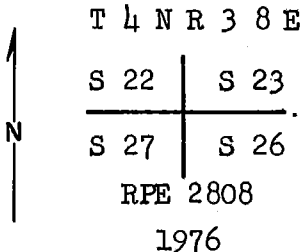

DESCRIBE CORNER MONUMENT FOUND

NONE

DESCRIBE BEARING TREES OR OTHER OFFICIAL ACCESSORIES FOUND

- A larch 12" dia. bears S 13° E., 16.5ft.(25 lks) with visible scribe marks.
- A larch 13" dia. bears S 25° W., 8.6 ft.(13 lks) with no visible scribe marks.
- A 12" stump with rotting tree alongside bears N 21 E., 6.6 ft. (10 lks) with visible scribe marks.

PHOTO IDENTIFICATION DATA

Photo No. _____
 Filed At. _____
 Object Ident. _____
 Ident. By _____
Signature

DESCRIBE CORNER LOCATION RELATIVE TO NEAR-BY FEATURES, ALSO HOW TO REACH CORNER

From road intersections to Troy, Oregon and Dayton, Wash., go 1.2 miles north and find location tag on left side of road. Thence go east 5 chains(330 ft.)

PLANE COORDINATE POSITION DATA

State _____ Zone _____
 X _____
 Y _____
 Estab. By _____

James D. Hanley
 Agency
 James D. Hanley

Title _____ Division _____ Headquarters _____ Date 6/29/76
 ORFE 2808 7100-52 (3/68)

CORNER RECORD (PERPETUATION)

MONUMENT: DESCRIBE NEW MONUMENT SET, OR WORK DONE TO PRESERVE EXISTING MONUMENT

Set a 2 1/2" brass cap on a 2" iron pipe 31" long 4" above the ground with a 6' steel fence post with a sign 54-4 attached 4' east of corner.

ACCESSORIES : DESCRIBE NEW BTs WITNESS OBJECTS ETC. ESTABLISHED, OR WORK DONE TO PRESERVE EXISTING EVIDENCE

A fir 9" diam. bears N 68° W., 27.0 ft. dist. marked T 4 N R 3 8 E S 22 B T
A spruce 18" diam. bears N 47° E., 21.8 ft. dist. marked T 4 N R 3 8 E S 23 B T
A spruce 12" diam. bears S 38° W., 31.4 ft. dist. marked T 4 N R 3 8 E S 27 B T

Each BT has a sign 54-3 attached 6" below a band of red paint and has a brass washer marked RPE 2808 nailed flush with BT blaze.

Work Done By James D. Hanley Title Engineer Date 7/2/76 State Registration No. ORPE 2808
or Agency

Certified Cor. Record Prepared ? Yes XX Filed At: Pendleton, Oregon Date 8/ /76

REMARKS

Index File No. R 17 T. 4 N R. 38 E W M.

Tract or Surv. No.

Cor.