

Index
File No. R-7


CORNER RECORD (SEARCH)
(Ref. FSM 7151.4)

Tract or Survey No. _____
Cor. No. _____

T 4N R. 38E
Merid. W

R.D. WW County Umatilla
N.F. Umatilla State OREGON

CORNER DIAGRAM

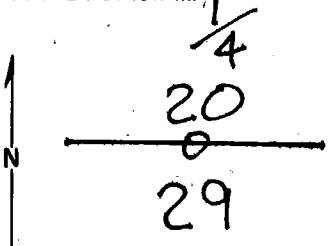

DESCRIBE CORNER MONUMENT FOUND

2 1/2" Brass-cap on 1" iron pipe 8" exposed with stone on north side. CAP is marked: us General land Office Survey Penalty \$ 250 For Removal
1/4 520

DESCRIBE BEARING TREES OR OTHER OFFICIAL ACCESSORIES FOUND

1939
Rotted remains W-harch at S40W at 48 lks
Rotted remains of felled true-fir at N42W at 65 lks. No visible marks on either BT remains.

PHOTO IDENTIFICATION DATA

Photo No. _____
Filed At. _____
Object Ident. _____
Ident. By _____
Signature _____

PLANE COORDINATE POSITION DATA

State _____ Zone _____
X _____
Y _____
Estob. By _____
Agency _____

DESCRIBE CORNER LOCATION RELATIVE TO NEAR-BY FEATURES, ALSO HOW TO REACH CORNER

Drive to spur 090 junction with 6401 RD. Hike south on spur 090 approx 1300 ft to location poster on west side spur. Hike west approx 200 ft to corner.

Signature Edwin A. Steyber Title PHS Division _____ Headquarters _____ Date 7/19/89 FS-7100-52 (3/68)

CORNER RECORD (PERPETUATION)

MONUMENT: DESCRIBE NEW MONUMENT SET, OR WORK DONE TO PRESERVE EXISTING MONUMENT

Cleared area around monument
Placed location poster on spur 090 ("west" 200 ft)

ACCESSORIES : DESCRIBE NEW BT'S WITNESS OBJECTS ETC. ESTABLISHED, OR WORK DONE TO PRESERVE EXISTING EVIDENCE

16" Spruce bears N 18 E at 8.5 ft scribed "1/4 S 20 BT"
18" Spruce bears S 19 E at 36.5 ft scribed "1/4 S 29 BT"
placed brass-washer PHS 2060 at base of both blazes

Work Done By E. A. Stryker Title OPHS Date 7/19/89 State Registration No. 2060
or Agency

Certified Cor. Record Prepared? Yes No Filed At: Uma Tilla Date

REMARKS

Painted Red Bands around both BT's
Placed 54-3(2) signs and 54-9 signs(2) on BT's
Placed 54-4 sign (1) near corner
Placed 54-9 sign on steel fence post set 1 ft east of cor

Index File No. R-7 T. 4N R. 38E M. W Tract or Surv. No. Cor. 13
GPO: 1982 O-382-659

Index
File No. R-7


CORNER RECORD (SEARCH)
(Ref. FSM 7151.4)

Tract or
Survey No. _____ Cor. R-7
No. _____

T 4N R. 38E R.D. Walla Walla County _____

Merid. Willamette N.F. Umatilla State Oregon

CORNER DIAGRAM

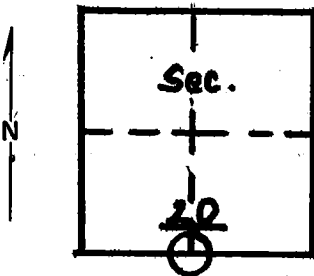

DESCRIBE CORNER MONUMENT FOUND

None

DESCRIBE BEARING TREES OR OTHER OFFICIAL ACCESSORIES FOUND

Run compass west from brass cap along good blaze line to tree blazed on 4 sides. Found no evidence.

PHOTO IDENTIFICATION DATA

Photo No. _____

Filed At. _____

Object Ident. _____

Ident. By _____

Signature

PLANE COORDINATE POSITION DATA

State _____ Zone _____

X _____

Y _____

Estab. By _____

Agency

Signature

Bill Moore

Title

Eng. Tech.

Division

Headquarters

Date

9/27/77

7100-52 (3/68)

CORNER RECORD (PERPETUATION)

MONUMENT: DESCRIBE NEW MONUMENT SET, OR WORK DONE TO PRESERVE EXISTING MONUMENT

ACCESSORIES : DESCRIBE NEW BT'S WITNESS OBJECTS ETC. ESTABLISHED, OR WORK DONE TO PRESERVE EXISTING EVIDENCE

Work Done By _____ Title _____ Date _____ State Registration No. _____
or Agency _____
Certified Cor. Record Prepared ? Yes No Filed At: _____ Date _____

REMARKS

Index File No. T. R. M. Tract or Surv. No. Cor. _____