


CORNER RECORD (PERPETUATION)

MONUMENT: DESCRIBE NEW MONUMENT SET, OR WORK DONE TO PRESERVE EXISTING MONUMENT

SET 2 1/2" DIA X 30" ALUM MON  
25" IN the ground. No stones  
available. CAP marked:

T4N R38E WM  
#N Y16

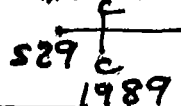

ACCESSORIES : DESCRIBE NEW BT's WITNESS OBJECTS ETC. ESTABLISHED, OR WORK DONE TO PRESERVE EXISTING EVIDENCE

BT 25" Spruce bears N 80 E at 25.4 ft  
scribed "CN Y16 529 BT"

STRYKER PHS 2060

BT 10" Spruce bears S 46 W at 52.3 ft  
scribed "CN Y16 529 BT"

Placed brass washers "PHS 2060" at base of both blazes

Work Done By E.A. Stryker Title OPKS Date 8/4/89 State Registration No. 2060  
or Agency

Certified Cor. Record Prepared?  Yes  No Filed At: umatilla city Date AUG 89

REMARKS

Painted red Band around BOTH BT's  
Placed 54-3 signs and 54-4 signs on both BT's  
Placed 54-9 sign and 54-2 sign on steel post set  
5 ft south of corner

USDA-FOREST SERVICE

Index S-7  
 File No. S-7

CORNER RECORD (SEARCH)

(Ref. FSM 7151.4)

Tract or Survey No. \_\_\_\_\_  
 Cor. No. \_\_\_\_\_


T 4N R. 38E

R.D. WW County UMATILLA

Merid. W

N.F. UMATILLA State OREGON

CORNER DIAGRAM

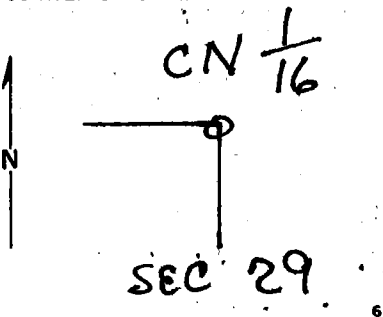

DESCRIBE CORNER MONUMENT FOUND

NOT SET BY GLO

2

DESCRIBE BEARING TREES OR OTHER OFFICIAL ACCESSORIES FOUND

NOT SET BY GLO

3

PHOTO IDENTIFICATION DATA

Photo No. \_\_\_\_\_

Filed At. \_\_\_\_\_

Object Ident. \_\_\_\_\_

Ident. By \_\_\_\_\_

*Signature*

7

PLANE COORDINATE POSITION DATA

State \_\_\_\_\_ Zone \_\_\_\_\_

X \_\_\_\_\_

Y \_\_\_\_\_

Estab. By \_\_\_\_\_

*Agency*

8

DESCRIBE CORNER LOCATION RELATIVE TO NEAR-BY FEATURES, ALSO HOW TO REACH CORNER

DRIVE TO END 030 SPUR OFF 6401 RD.  
 FOLLOW POSTED LINE NORTH APPROX.  
 1320 ft to corner.

4

Signature Edwin A. Styer

Title PHS

Division \_\_\_\_\_

Headquarters \_\_\_\_\_

Date 5/4/89

FS-7100-52 (3/68)

5