

USDA-FOREST SERVICE

Index

File No. T-13

CORNER RECORD (SEARCH)

(Ref. FSM 7151.4)

Tract or Survey No. \_\_\_\_\_ Cor. No. \_\_\_\_\_

T 4N R. 38E

R.D. Walla Walla County Umatilla

Merid. Willamette

N.F. Umatilla State Oregon

CORNER DIAGRAM



T4N R38E  
 S  $\frac{1}{4}$   
 S28 | S27  
 RPE 2808  
 1976

DESCRIBE CORNER MONUMENT FOUND

Found 2½" brass cap on a 2½" galv. iron pipe projecting 1" out of a stone mound.

2

DESCRIBE BEARING TREES OR OTHER OFFICIAL ACCESSORIES FOUND

A 10" dead lodgepole pine bears S 47°E, 6.0' with visible scribes on a partly healed double blaze. (RPE 2808).

A 10" dying white fir bears N 77°W, 25.5' with visible scribes on a partly healed double blaze. (RPE 2808).

3

PHOTO IDENTIFICATION DATA

Photo No. \_\_\_\_\_

Filed At. \_\_\_\_\_

Object Ident. \_\_\_\_\_

Ident. By \_\_\_\_\_

*Signature*

6

DESCRIBE CORNER LOCATION RELATIVE TO NEAR-BY FEATURES, ALSO HOW TO REACH CORNER

Corner is located on the west side of a drainage flowing Northwest, just north of road. Corner is visible from road.

PLANE COORDINATE POSITION DATA

State \_\_\_\_\_ Zone \_\_\_\_\_

X \_\_\_\_\_

Y \_\_\_\_\_

Estab. By \_\_\_\_\_

*Agency*

8

*Signature*

*Will R. Wells*

Title

PLS

Division

Headquarters

Pendleton, OR

Date

9/4/91

FS-7100-52 (3/69)

4

5

### CORNER RECORD (PERPETUATION)

**MONUMENT: DESCRIBE NEW MONUMENT SET, OR WORK DONE TO PRESERVE EXISTING MONUMENT**

Maintained existing monument by remounding with earth and stone and cleaning up around it. Set steel fence post south of corner monument with sign 54-9 attached.

**ACCESSORIES: DESCRIBE NEW BT'S, WITNESS OBJECTS ETC. ESTABLISHED, OR WORK DONE TO PRESERVE EXISTING EVIDENCE**

Marked 4 new bearing trees:

A 12" englemann spruce bears S  $78\frac{1}{2}^{\circ}$  E, 29.1' scribed 1/4 S27 BT.

A 20" englemann spruce bears N  $21^{\circ}$  E, 31.6' scribed 1/4 S27 BT.

A 18" western larch bears N  $48\frac{1}{2}^{\circ}$  W, 39.1' scribed 1/4 S28 BT.

A 21" englemann spruce bears S  $87\frac{1}{2}^{\circ}$  W, 13.9' scribed 1/4 S28 BT.

New bearing trees have a brass washer stamped PLS 1106 nailed to face of blaze. Attached sign 54-3 and 54-9 and painted face of blaze and a 6" red band around all bearing trees.

10

Work Done By W. E. Wells Title PLS Date 9/4/91 State Registration No. 1106  
or Agency

Certified Cor. Record Prepared? Yes  No  Filed At: Umatilla Co. Surveyor Off. Date 12/91

11

**REMARKS**

Index File No. T-13 T. 4N R. 38E M. Will. Tract or Surv. No.

Cor.

12

13

Index  
File No. T 13  
T LN R. 38E  
Merid. Willamette


CORNER RECORD (SEARCH)

(Ref. FSM 7151.4)

Tract or  
Survey No. \_\_\_\_\_  
Cor.  
No. T 13

R.D. Walla Walla County Umatilla  
N.F. Umatilla State Oregon

CORNER DIAGRAM

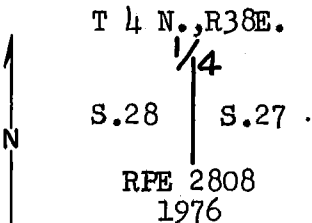

DESCRIBE CORNER MONUMENT FOUND

Found a basalt stone 13" x 10" x 6" in place 7" above ground with 1/4 chisled on west face and an X chisled on top point.

DESCRIBE BEARING TREES OR OTHER OFFICIAL ACCESSORIES FOUND

Found a badly decomposed stump bears N 78° W., 98 lks dist. for sec. 28 BT no visible scribing.  
Found nearly completely decomposed stump bears S 80° E., 56 lks dist. for sec. 27 BT No visible scribing.

PHOTO IDENTIFICATION DATA

Photo No. \_\_\_\_\_  
Filed At. \_\_\_\_\_  
Object Ident. \_\_\_\_\_  
Ident. By \_\_\_\_\_  
*Signature*

DESCRIBE CORNER LOCATION RELATIVE TO NEAR-BY FEATURES, ALSO HOW TO REACH CORNER

100 feet left of station 57+50 of newly cut right of way of Forest Service L U P road.

PLANE COORDINATE POSITION DATA

State \_\_\_\_\_ Zone \_\_\_\_\_  
X \_\_\_\_\_  
Y \_\_\_\_\_  
Estab. By \_\_\_\_\_

*James D. Hanley*  
Signature  
James D. Hanley

Title

Division  
ORPE 2808

Headquarters

Date  
6/29/76

7100-52 (3/68)

2

6

3

4

5

CORNER RECORD (PERPETUATION)

MONUMENT: DESCRIBE NEW MONUMENT SET, OR WORK DONE TO PRESERVE EXISTING MONUMENT

Set a 2 1/2 " brass cap on 2" iron pipe 31" long 6" above ground in earth and rock mound with a 6' steel fence post with sign 54-4 attached alongside.

ACCESSORIES : DESCRIBE NEW BT'S WITNESS OBJECTS ETC. ESTABLISHED, OR WORK DONE TO PRESERVE EXISTING EVIDENCE

A pine 10" dia. bears S 47° E., 6.0 ft. dist. marked 1/4 S 27 BT  
A fir 9" dia. bears N 77° W., 25.5 ft. dist. marked 1/4 S 28 BT

Each BT has sign 54-3 attached 6" below a band of red paint with a brass washer marked RPE 2808 nailed flush with BT blaze.

Work Done By. James D. Hanley Title Engineer Date 6/30/76 State Registration No. ORPE 2808  
or Agency

Certified Cor. Record Prepared? Yes  Filed At: Pendleton, Oregon Date 8/ /76

REMARKS

Buried stone on north side of brass cap monument