

USDA-FOREST SERVICE

INDEX
 FILE NO. T-5 CORNER RECORD (SEARCH)
 (Ref. FSM 7151.4) Tract or
 T. 4 N R. 38 E R.D. Walla Walla County Umatilla Cor.
 Merid. Willamette N.F. UMATILLA State Oregon No. 1

CORNER DIAGRAM 1 DESCRIBE CORNER MONUMENT FOUND
 1 1/4 1 Found standard 2 1/2" GLO brass cap stamped as shown in the diagram.
 1 S30 | S29 1
 N 1939 1
 1 1
 1 2

1 DESCRIBE BEARING TREES OR OTHER OFFICIAL ACCESSORIES FOUND
 1 Found a 24" dbh Engleman Spruce N50°00"W, 8.0' with healed blaze.
 PHOTO IDENTIFICATION DATA 1 Found a 34" dbh Engleman Spruce S41°00'E, 3.3' with healed blaze.
 Photo No. 1
 Filed At. 1
 Object Ident. 1
 Ident. By 1
 Signature 71 3

PLANE COORDINATE POSITION DATA 1 DESCRIBE CORNER LOCATION RELATIVE TO NEAR-BY FEATURES, ALSO HOW TO REACH CORNER
 State Zone 1 The corner may be reached by traveling the McIntyre Road from the Tollgate Store 0.2 mile
 X 1 to the top of a small hill. At the top of the hill take a dirt road traveling northeasterly.
 Y 1 Follow this road 0.6 mile to a four way junction. Walk straight ahead on the dim road going
 Estab. By 1 north. Follow this road 300 feet and cross through a gate. Go past the gate 100' and follow
 Agency 81 a cut out line 150' west to the corner at the southwesterly corner of an alder patch 4

Signature Title Division Headquarters Date FS-7100-52 (3/68)
 Surveyor Pendleton, OR 9-04-95 5

CORNER RECORD (PERPETUATION)

MONUMENT : DESCRIBE NEW MONUMENT SET, OR WORK DONE TO PRESERVE EXISTING MONUMENT

Cleared brush away from the corner.

9

ACCESSORIES : DESCRIBE NEW BT'S WITNESS OBJECTS ETC. ESTABLISHED, OR WORK DONE TO PRESERVE EXISTING EVIDENCE

Set new bearing trees.

A 17" dbh Alpine Fir bears S71°00'W, 43.7' scribed 1/4 S30 BT.

A 6" dbh White Fir bears N10°49'E, 58.5' scribed 1/4 S29 BT.

A brass washer stamped ORLS 852 and WAL5 13922 is nailed between the letters B and T on each new tree with a brass screw. All the BT' have BT and LSM signs attached. A red band is painted around each tree at chest height.

Work Done By. David L. Maddock Title Land Surveyor Date 8-17-95 State Registration No. _____
Certified Cor. Record Prepared? x Yes No Filed At: Umatilla County Surveyor Date 9-95 11

REMARKS

12

Index File No. T-5 T. 4 N. R. 38 E. W. Willamette Tract or Surv. No. _____ Cor. _____

13

USDA-FOREST SERVICE

Index File No. T-5

CORNER RECORD (SEARCH)

(Ref. FSM 7151.4)

Tract or Survey No. _____ Cor. No. _____


T 4N R. 38E

R.D. WW County Umatilla

Merid. W

N.F. Umatilla State OREGON

CORNER DIAGRAM

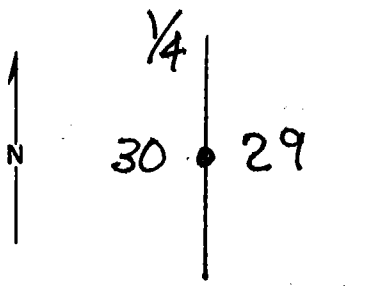

DESCRIBE CORNER MONUMENT FOUND

2 1/2" Brass cap on 1" iron pipe 7" exposed at base (NW) of large spruce; NO STONES CAP MARKED: us general land office survey Penalty \$250 For Removal
 1/4 530 | 529

DESCRIBE BEARING TREES OR OTHER OFFICIAL ACCESSORIES FOUND

23 1/2" Spruce bears N50W at 8.0 ft 1939 with healed blaze and Umatilla Cty Surveyor BT Tag 9/24/72 ATL
 31" Spruce bears S41E at 3.3 ft with healed blaze

PHOTO IDENTIFICATION DATA

Photo No. _____
 Filed At. _____
 Object Ident. _____
 Ident. By _____
 Signature

DESCRIBE CORNER LOCATION RELATIVE TO NEAR-BY FEATURES, ALSO HOW TO REACH CORNER

Drive to end 030 spur off 6401 RD. Hike west across private land 1/2 mile to corner.

PLANE COORDINATE POSITION DATA

State _____ Zone _____
 X _____
 Y _____
 Estob. By _____
 Agency

Signature Edwin A. Stricker Title PHS Division _____ Headquarters _____ Date 7/18/89 FS-7100-52 (3/68)

CORNER RECORD (PERPETUATION)

MONUMENT: DESCRIBE NEW MONUMENT SET, OR WORK DONE TO PRESERVE EXISTING MONUMENT

cleared area around monument

ACCESSORIES : DESCRIBE NEW BT'S WITNESS OBJECTS ETC. ESTABLISHED, OR WORK DONE TO PRESERVE EXISTING EVIDENCE

Painted RED BANDS AROUND BT'S
PLACED 54-3 sign (1) and 54-9 signs (2) ON BT'S
Placed 54-4 sign (1) near corner

Work Done By E.A. Stryker Title OPHS Date 7/18/89 State Registration No. 2060
or Agency

Certified Cor. Record Prepared? Yes No Filed At: umatilla Cty Date Aug 89

REMARKS

Placed 54-9 sign on steel fence post set 1^{ft} north of corner.

Index File No.

T-5

T.

4N

R.

30E

M.

W

Tract or Surv. No.

Cor.

Index

File No. T-5

CORNER RECORD (SEARCH)


(Ref. FSM 7151.4)

Tract or Survey No. _____ Cor. No. T-5

T 4N R. 38 E R.D. Walla Walla County _____

Merid. Willamette N.F. Umatilla State Oregon

CORNER DIAGRAM

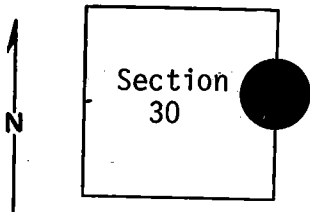

DESCRIBE CORNER MONUMENT FOUND

Brass Cap. Size: $2\frac{1}{2}$ ".
6" above ground; good condition.

DESCRIBE BEARING TREES OR OTHER OFFICIAL ACCESSORIES FOUND

40" spruce bears S 41° E, 1' distance from corner. Scribed on northwest face: S30 B.T. (I placed Forest Service B.T. poster on it.)
28" spruce bears N 50° W, 6' distance with closed southeast blaze and a Umatilla County B.T. poster on east side dated 9/24/72 AJL.

PHOTO IDENTIFICATION DATA

Photo No. _____

Filed At. _____

Object Ident. _____

Ident. By _____

Signature

PLANE COORDINATE POSITION DATA

State _____ Zone _____

X _____

Y _____

Estab. By _____

Agency

Signature
B. Moore

Title
Engineering Technician

Division
Headquarters
S.O.

Date
August 1975

7100-52-(3/68)

CORNER RECORD (PERPETUATION)

MONUMENT: DESCRIBE NEW MONUMENT SET, OR WORK DONE TO PRESERVE EXISTING MONUMENT

9

ACCESSORIES : DESCRIBE NEW BT'S WITNESS OBJECTS ETC. ESTABLISHED, OR WORK DONE TO PRESERVE EXISTING EVIDENCE

There is a fence north and east (28" spruce B.T. is fence corner).

Primitive road with locked gate 150' east of corner.

10

Work Done By _____ Title _____ Date _____ State Registration No. _____
or Agency _____

Certified Cor. Record Prepared ? Yes No Filed At: _____ Date _____

REMARKS

12

Index File No. T. R. M. Tract or Surv. No. Cor. 13
