

USDA-FOREST SERVICE

Index  
File No. T-7

CORNER RECORD (SEARCH)

(Ref. FSM 7151.4)

Tract or  
Survey No. \_\_\_\_\_

Cor.  
No. \_\_\_\_\_


T 4N R. 38E

R.D. WW County UMATILLA

Merid. W

N.F. UMATILLA State OREGON

CORNER DIAGRAM

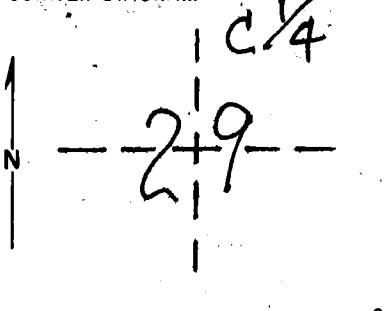

DESCRIBE CORNER MONUMENT FOUND

NOT SET BY GLO

DESCRIBE BEARING TREES OR OTHER OFFICIAL ACCESSORIES FOUND

NOT SET BY GLO

PHOTO IDENTIFICATION DATA

Photo No. \_\_\_\_\_

Filed At. \_\_\_\_\_

Object Ident. \_\_\_\_\_

Ident. By \_\_\_\_\_

Signature

PLANE COORDINATE POSITION DATA

State \_\_\_\_\_ Zone \_\_\_\_\_

X \_\_\_\_\_

Y \_\_\_\_\_

Estab. By \_\_\_\_\_

Agency

DESCRIBE CORNER LOCATION RELATIVE TO NEAR-BY FEATURES, ALSO HOW TO REACH CORNER

DRIVE TO END 030 SPUR OFF 6401  
Rd. Hike N-west Approx 300 ft to corner.  
POSTED LINE IS WEST 100 FT FROM SPUR-  
FOLLOW IT NORTH.

Signature Edwin A. Stryker

Title PHS

Division \_\_\_\_\_

Headquarters \_\_\_\_\_

Date 8/4/89

FS-7100-52 (3/68)

CORNER RECORD (PERPETUATION)

MONUMENT: DESCRIBE NEW MONUMENT SET, OR WORK DONE TO PRESERVE EXISTING MONUMENT

SET 2 1/2" DIA X 30" ALUM MON  
24" IN GROUND. NO STONES  
AVAILABLE. CAP MARKED:

T4N R38E WM  
CY4



ACCESSORIES: DESCRIBE NEW BT'S WITNESS OBJECTS ETC. ESTABLISHED, OR WORK DONE TO PRESERVE EXISTING EVIDENCE

STRYKER PHS 2060

BT 8" True fir bears N46E at 11.8 ft  
scribed "CY4 S29 BT"

BT 10" True fir bears S08W at 33.7 ft  
scribed "CY4 S29 BT"

Work Done By E. A. Stryker Title OPHS Date 8/4/89 State Registration No. 2060  
or Agency

Certified Cor. Record Prepared?  Yes  No Filed At: Umatilla Cty Date AUG 89

REMARKS

PAINTED RED BANDS AROUND ALL BT'S  
PLACED 54-3 signs and 54-4 signs on both BT'S  
Placed 54-9 sign and 54-2 sign on steel post 5ft north  
Placed Brass washer "PHS 2060" AT BASE OF BOTH BLAZES

Index File No. T-7 T. 4N R. 38E M. W Tract or Surv. No. W Cor. 9  
GPO: 1982 O-382-659