

USDA-FOREST SERVICE

Index
File No. U-6

CORNER RECORD (SEARCH)

(Ref. FSM 7151.4)

Tract or Survey No. _____
Cor. No. _____


T 4N R. 30E

R.D. WW County UMATILLA

Merid. W

N.F. UMATILLA State OREGON

CORNER DIAGRAM

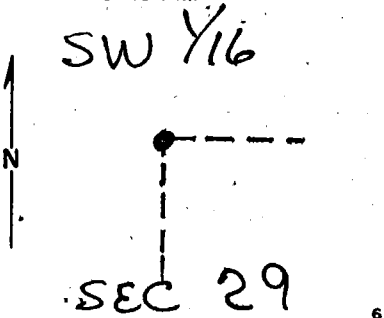

DESCRIBE CORNER MONUMENT FOUND

NOT SET BY GLO

DESCRIBE BEARING TREES OR OTHER OFFICIAL ACCESSORIES FOUND

NOT SET BY GLO

PHOTO IDENTIFICATION DATA

Photo No. _____
Filed At. _____
Object Ident. _____
Ident. By _____
Signature

DESCRIBE CORNER LOCATION RELATIVE TO NEAR-BY FEATURES, ALSO HOW TO REACH CORNER

DRIVE TO END OF SOUTH SPUR ON 030 SPUR OFF 6401 RD to powerline x-ing. Hike N-west on powerline corridor: to posted line (approx 1320 ft). Then go North on posted line approx 200 ft to corner.

PLANE COORDINATE POSITION DATA

State _____ Zone _____
X: _____
Y: _____
Estab. By _____
Agency

Edwin A. Stryker Signature Title PAS Division _____ Headquarters _____ Date 8/4/89 FS-7100-52 (3/68)

CORNER RECORD (PERPETUATION)

MONUMENT: DESCRIBE NEW MONUMENT SET, OR WORK DONE TO PRESERVE EXISTING MONUMENT

SET 2 1/2" DIA X 30" ALUM MON
 24" IN GROUND. NO STONES AVAILABLE.
 CAP MARKED!

T4N R38E WM1
 SW 1/6

529
 1989

STRYKER PLS 2060

ACCESSORIES: DESCRIBE NEW BT'S WITNESS OBJECTS ETC. ESTABLISHED, OR WORK DONE TO PRESERVE EXISTING EVIDENCE

BT 10" True fir bears N88E at 17.5 ft.
 scribed "SW 1/6 529 BT"

BT 12" LP Pine bears S 0 W at 23.8 ft.
 scribed "SW 1/6 529 BT"

Placed brass washer "PLS 2060" at base of both blazes

Work Done By: E.A. Stryker Title OPKS Date 8/4/89 State Registration No. 2060
 or Agency

Certified Cor. Record Prepared? Yes No Filed At: UMATILLA CTY Date AUG 89 11

REMARKS

Painted red bands around both BT's
 Placed 54-3 signs and 54-4 signs on both BT's
 Placed 54-9 sign and 54-2 sign on steel post set
 5ft east of corner

Index File No.

U-6

T.

4N

R.

38E

M.

W

Tract or Surv. No.

Cor.