

USDA-FOREST SERVICE

Index
File No. V-8

CORNER RECORD (SEARCH)

(Ref. FSM 7151.4)

Tract or Survey No. _____
Cor. No. V-8


T 4N R. 38E

R.D. WALLA WALLA County UMATILLA

Merid. Willamette

N.F. UMATILLA State OREGON

CORNER DIAGRAM

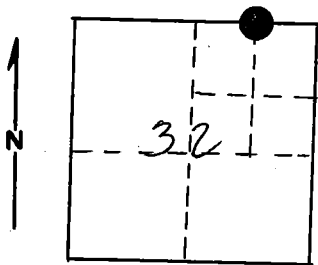

DESCRIBE CORNER MONUMENT FOUND

END 1" PIPE WITH BRASS CAP SET BY UMATILLA COUNTY SURVEYOR. CAP FIRMLY SET 12" EXPOSED ABOVE GROUND.

DESCRIBE BEARING TREES OR OTHER OFFICIAL ACCESSORIES FOUND

NONE

PHOTO IDENTIFICATION DATA

Photo No. _____
Filed At. _____
Object Ident. _____
Ident. By _____
Signature

PLANE COORDINATE POSITION DATA

State _____ Zone _____
X _____
Y _____
Estab. By _____
Agency

DESCRIBE CORNER LOCATION RELATIVE TO NEAR-BY FEATURES, ALSO HOW TO REACH CORNER

FROM JCT. OF 6401 ROAD & 6401-019 RD, DRIVE WEST ON 019 - 0.5 mile WACK SOUTH 600 FT TO CORNER.

Signature

Gregory T. Blackman Surveyor

Title

Division

Headquarters

Date

7-85

7100-52 (3-68)

CORNER RECORD (PERPETUATION)

MONUMENT: DESCRIBE NEW MONUMENT SET, OR WORK DONE TO PRESERVE EXISTING MONUMENT

set fence post 5⁰ South w/54-2 559-9 sign.

ACCESSORIES: DESCRIBE NEW BT'S WITNESS OBJECTS ETC. ESTABLISHED, OR WORK DONE TO PRESERVE EXISTING EVIDENCE

New BT's:

AN 8" spruce bears S 4 W 26⁰ FT MARKED E 1/16 S 32 BT.

A 10" spruce bears N 40 W 8² FT. MARKED E 1/16 S 29 BT.

PAINTED Red BANDS AROUND TREES AND PLACED LAND SURVEY MON. SIGNS ON TREES.

Work Done By: Greg Black Title Surveyor Date 7-85 State Registration No. or Agency OPLS 991

Certified Cor. Record Prepared? Yes No Filed At: WILLAMETTE County Surveyor Date 7-85

REMARKS

Index File No. V-8 T. 4N R. 38E M. Willamette Tract or Surv. No.

Cor. E 1/16