

USDA-FOREST SERVICE

Index File No. V-9

CORNER RECORD (SEARCH)

(Ref. FSM 7151.4)

Tract or Survey No. \_\_\_\_\_

Cor. No. \_\_\_\_\_


T 4N R. 38E

R.D. WW County UMATILLA

Merid. W

N.F. UMATILLA State OREGON

CORNER DIAGRAM

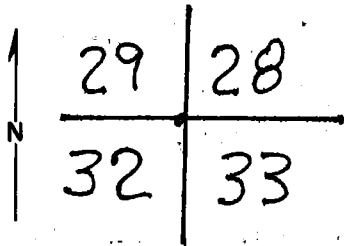

DESCRIBE CORNER MONUMENT FOUND

FOUND  $2\frac{1}{2}$ " DIA BRASS CAP ON 2" IRON PIPE 8" EXPOSURE. NO STONES. CAP MARKED!

U.S. General Land Office SURVEY

PENALTY \$250 FOR REMOVAL

T4N R38E

S29/S28

S32/S33

1989

DESCRIBE BEARING TREES OR OTHER OFFICIAL ACCESSORIES FOUND

16" Spruce bears (N<sup>N36E</sup>36E) at 11.1 ft.; blaze healed  
 16" Spruce bears (S<sup>S59E</sup>59E) at 6.3 ft.; visible scribing of "N R 38 E S 33"  
 dead and down true-fir scribed "T4N R38E S29"

PHOTO IDENTIFICATION DATA

Photo No. \_\_\_\_\_  
 Filed At. \_\_\_\_\_  
 Object Ident. \_\_\_\_\_  
 Ident. By \_\_\_\_\_

Signature

PLANE COORDINATE POSITION DATA

State \_\_\_\_\_ Zone \_\_\_\_\_  
 X \_\_\_\_\_  
 Y \_\_\_\_\_  
 Estab. By \_\_\_\_\_

Agency

DESCRIBE CORNER LOCATION RELATIVE TO NEAR-BY FEATURES, ALSO HOW TO REACH CORNER

DRIVE ON SPUR 019 OFF 6401 RD APPROX 3/8 mile to location tag ON SOUTH SIDE SPUR (BEFORE GATE); HIKE SOUTH APPROX. 200 FT. TO CORNER.

Signature Edwin A. Stricker Title PKS

Division \_\_\_\_\_ Headquarters \_\_\_\_\_

Date

7/18/89

FS-7100-52 (3/68)

CORNER RECORD (PERPETUATION)

MONUMENT: DESCRIBE NEW MONUMENT SET, OR WORK DONE TO PRESERVE EXISTING MONUMENT

cleared area around MONUMENT AS BEST AS POSSIBLE - the dead / down tree - fir BT is a blow down and root wad. AND BOHE ARE AT MONUMENT ON WEST SIDE. NEED CAT TO MOVE.

ACCESSORIES : DESCRIBE NEW BT'S WITNESS OBJECTS ETC. ESTABLISHED, OR WORK DONE TO PRESERVE EXISTING EVIDENCE

18" Spruce bears S59 W at 41.8 ft.; scribed "T4N R38E S32 BT"  
 21" Spruce bears N43 W at 40.9 ft.; scribed "T4N R38E S29 BT"  
 placed brass-washers PLS 2060 at base of both blazes

Work Done By E.A. Stryker Title OPHS Date 7/18/89 State Registration No. 2060  
 or Agency  
 Certified Cor. Record Prepared?  Yes No Filed At: UMATILKA CTY Date AUG 89

REMARKS

PAINTED RED BANDS AROUND ALL BT'S  
 Placed 54-3 signs (5) and 54-9 signs (4) on all BT'S  
 Placed 54-4 sign (1) near corner  
 Placed 54-9 sign on steel fence post 0'2" north of COR<sub>12</sub>

Index File No. V-9 T. 4N R. 38E M. W Tract or Surv. No. Cor. 12  
 GPO: 1982 O-382-659