

Index

File No. X-16

CORNER RECORD (SEARCH)

(Ref. FSM 7151.4)

Tract or

Survey No. \_\_\_\_\_

Cor.

No. 116


T 4N R. 30E

R.D. Walla Walla County Umatilla

Merid. Will

N.F. Umatilla State OR

CORNER DIAGRAM

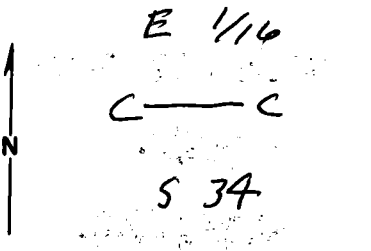

DESCRIBE CORNER MONUMENT FOUND

NONE

DESCRIBE BEARING TREES OR OTHER OFFICIAL ACCESSORIES FOUND

NONE

PHOTO IDENTIFICATION DATA

Photo No. \_\_\_\_\_

Filed At. \_\_\_\_\_

Object Ident. \_\_\_\_\_

Ident. By \_\_\_\_\_

Signature

PLANE COORDINATE POSITION DATA

State \_\_\_\_\_ Zone \_\_\_\_\_

X \_\_\_\_\_

Y \_\_\_\_\_

Estab. By \_\_\_\_\_

Agency

Signature

*D. Dennis Edwards*

Title

LS

Division

Headquarters

Hermiston

Date

7/19/05

7100-52 (3. 68)

DESCRIBE CORNER LOCATION RELATIVE TO NEAR-BY FEATURES, ALSO HOW TO REACH CORNER

From Jct. Rd. # 6401 with # 69

Go ~~East~~ on # 69 1.7 mile  
To private Road. Take private Rd. north  
and East 0.25 mile to Angle point to  
the North. Corner lies 150'± East of L.

CORNER RECORD (PERPETUATION)

MONUMENT: DESCRIBE NEW MONUMENT SET, OR WORK DONE TO PRESERVE EXISTING MONUMENT

Set a 2" x 30" Iron pipe with B.C. stamped in ground and placed a mound of stone.

CE 1/16 534  
1985  
LS 951

25"

Drove a steel fence post 3ft. North and attached 54-9 sign.

ACCESSORIES: DESCRIBE NEW BT'S WITNESS OBJECTS ETC. ESTABLISHED, OR WORK DONE TO PRESERVE EXISTING EVIDENCE

A 11" fir bears S 81 1/2° W 12.8 ft scribed CE 1/16 534 BT

A 11" Fir Bears S 35° E 11.5 ft. scribed CE 1/16 534 BT.

Painted Blazos red and nailed alum. tag # 951 to BTm.

Painted red Band around BT's & nailed USFS signs 54-3 & 54-9 on.

Work Done By G. D. Edwards Title LS Date 7/19/85 State Registration No. OR 951  
or Agency

Certified Cor. Record Prepared?  No Filed At: Pendleton OR Date 7/19/85

REMARKS