

USDA-FOREST SERVICE

Index

File No. Z-11

CORNER RECORD (SEARCH)

(Ref. FSM 7151.4)

Tract or

Survey No. _____

Cor.

No. _____

T 4N R. 30E

R.D. Walla Walla

County Umatilla


State _____

Merid. Will

N.F. Umatilla

State OR

CORNER DIAGRAM

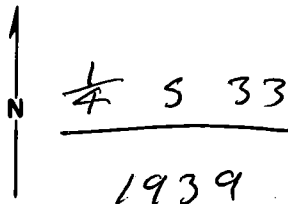

DESCRIBE CORNER MONUMENT FOUND

Find 1" Iron pipe firmly in ground with B.C. marked as diagram

DESCRIBE BEARING TREES OR OTHER OFFICIAL ACCESSORIES FOUND

A 16" ^{Lodge pole} pine stump bears S 09° W 3.3 ft part of Blaze
 a 12" ^{Lodge pole} down pine, root hole bears N 33° E 9.9 ft. ^{vis.} some marks visible.
 A 14" Fir Bears N 35° W 11 1/2 ft. Marks visible on partially healed Blaze 3

PHOTO IDENTIFICATION DATA

Photo No. _____

Filed At. _____

Object Ident. _____

Ident. By _____

Signature

PLANE COORDINATE POSITION DATA

State _____ Zone _____

X _____

Y _____

Estab. By _____

Agency

DESCRIBE CORNER LOCATION RELATIVE TO NEAR-BY FEATURES, ALSO HOW TO REACH CORNER

From Jet Rd # 64 with Hwy 209
 Go Ely on Hwy 209 0.1 mile
 Corner lies 250 ft ± East of Hwy
 50' ± South of power line Road

Signature

Title

Division

Headquarters

Date

7100-52 (3. 68)

D. Dennis Edwards

LS 951

Hermiston

7/19/85

CORNER RECORD (PERPETUATION)

MONUMENT: DESCRIBE NEW MONUMENT SET, OR WORK DONE TO PRESERVE EXISTING MONUMENT

I drove a steel fence post 3 ft. East and attached
54-4 sign

ACCESSORIES: DESCRIBE NEW BT'S WITNESS OBJECTS ETC. ESTABLISHED, OR WORK DONE TO PRESERVE EXISTING EVIDENCE

New B.T.

A 13' ^{Lodgepole} pine Bears N 12° E 135 ft. scribed. 1/4 S33 BT

I nailed alum. tag # 951 to Btm Blaze & painted all blazes red.
Painted red Band around all BT's and nailed 54-3 & 54-4 signs on

Work Done By G. D. Edwards Title LS Date 7/19/05 State Registration No. or Agency OR 951

Certified Cor. Record Prepared? No Filed At: Pendleton, OR Date 7/19/05

REMARKS

Index
File No. Z 11

CORNER RECORD (SEARCH)

(Ref. FSM 7151.4)

Tract or Survey No. _____ Cor. No. _____

T 4N R. 38E


R.D. Walla Walla County Umatilla/Union

Merid. Will

N.F. Umatilla State Oregon

CORNER DIAGRAM

T 4N R 38E

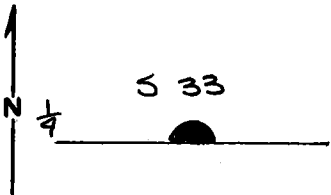

DESCRIBE CORNER MONUMENT FOUND

Found iron post, 1" dia, with brass cap ~~firm~~ ^{firm} in ground

DESCRIBE BEARING TREES OR OTHER OFFICIAL ACCESSORIES FOUND

Orig. 12" pine is down with open blaze but no visible scribes and bears N 33°E, 10 ft from corner. Put up BT sign. (old BT)
Orig. 10" pine is now a stump and bears S 89°W, 3 ft from corner. (old BT, was obliterated)
Orig. 8" fir is alive, now 12", with scribing visible and bears N 35°W, 11 ft from corner (new B.T.).

PHOTO IDENTIFICATION DATA

Photo No. _____
Filed At. _____
Object Ident. _____
Ident. By _____
Signature

DESCRIBE CORNER LOCATION RELATIVE TO NEAR-BY FEATURES, ALSO HOW TO REACH CORNER

Hwy 204 runs nearby

PLANE COORDINATE POSITION DATA

State _____ Zone _____
X _____
Y _____
Estab. By _____
Agency

Signature

Title

Division

Headquarters

Date

7100-52-(3-68)

Due Newstetter

Civil Eng Tech

SO

6/25/84

CORNER RECORD (PERPETUATION)

MONUMENT: DESCRIBE NEW MONUMENT SET, OR WORK DONE TO PRESERVE EXISTING MONUMENT

ACCESSORIES : DESCRIBE NEW BT'S WITNESS OBJECTS ETC. ESTABLISHED, OR WORK DONE TO PRESERVE EXISTING EVIDENCE

Work Done By _____ Title _____ Date _____ State Registration No. or Agency _____

Certified Cor. Record Prepared? Yes No Filed At: _____ Date _____

REMARKS

Index File No. T. R. M. Tract or Surv. No. Cor.