

Index

File No. Z-15

CORNER RECORD (SEARCH)

(Ref. FSM 7151.4)

Tract or

Survey No. _____

Cor.

No. _____

T 4 N R. 38 E

R.D. Walla Walla


County Umatilla

Merid. Will

N.F. Umatilla

State OR

CORNER DIAGRAM

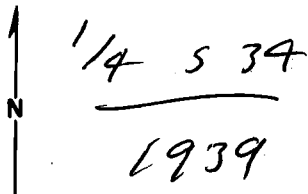

DESCRIBE CORNER MONUMENT FOUND

Find 1" Iron pipe with B.C. 4' out of ground stamped as diagram

DESCRIBE BEARING TREES OR OTHER OFFICIAL ACCESSORIES FOUND

A 42" spruce Bears S 79° W 42' At some marks viz on partially healed blaze

A 24" Fir Bears N 51° W 16.5 ft 1/4 S 34 BT visible

A 24" Fir snag Bears N 32° E 30.9 ft. no marks

PHOTO IDENTIFICATION DATA

Photo No. _____

Filed At. _____

Object Ident. _____

Ident. By _____

Signature

PLANE COORDINATE POSITION DATA

State _____ Zone _____

X _____

Y _____

Estab. By _____

Agency

DESCRIBE CORNER LOCATION RELATIVE TO NEAR-BY FEATURES, ALSO HOW TO REACH CORNER

From Jct Rd # 6401 with # 64

Go East on Rd # 64 1.6 mile to USFS type "A" sign

Go south parallel with E west of creek btm 20 to 40' to corner

corner lies 50' ± south of Looking glass Cr.

Signature

Title

Division

Headquarters

Date

7100-52 (3. 68)

Dennis Edward L S

Hermiston

7/19/85

CORNER RECORD (PERPETUATION)

MONUMENT: DESCRIBE NEW MONUMENT SET, OR WORK DONE TO PRESERVE EXISTING MONUMENT

ACCESSORIES : DESCRIBE NEW BT'S WITNESS OBJECTS ETC. ESTABLISHED, OR WORK DONE TO PRESERVE EXISTING EVIDENCE

Drove steel fence post 3' SW. of cor & attached 54-4 sign.
Painted red band around BT's, painted blazes, & nailed
54-3 & 54-4 signs to them.

Work Done By G.D. Edwards Title LS Date 7/19/05 State Registration No. OR 951
or Agency

Certified Cor. Record Prepared? Yes No Filed At: _____ Date _____

REMARKS

Index File No. Z-15 T. 4N R. 30E M. W. 11 Tract or Surv. No. _____ Cor. _____

USDA-FOREST SERVICE

Index

File No. 215

CORNER RECORD (SEARCH)

(Ref. FSM 7151.4)

Tract or

Survey No. _____

Cor.

No. _____

T 4N R. 38E

R.D. Walla Walla County Umatilla/Union


Merid. Will

N.F. Umatilla State Oregon

CORNER DIAGRAM

T4N R38E

534

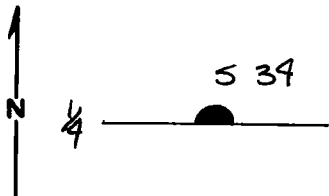

DESCRIBE CORNER MONUMENT FOUND

Found ironpost, 1" dia., with brass cap almost flush with ground and slightly bent over.

DESCRIBE BEARING TREES OR OTHER OFFICIAL ACCESSORIES FOUND

Orig. 40" spruce is alive, ~~NW~~ 42", with BT sign on it and bears S79°W, 42 ft from corner. (old B.T.)

Orig. 29" fir is dead and blown over with no marks visible but fits bearing which is N32°E, 30 ft from corner. Put up BT + attn. sign. (new B.T.)

Orig. 18" fir is alive, now 29" with open blaze and scribing visible and bears N51°W, 16.5 ft from corner. (new B.T.)

DESCRIBE CORNER LOCATION RELATIVE TO NEAR-BY FEATURES, ALSO HOW TO REACH CORNER

PHOTO IDENTIFICATION DATA

Photo No. _____

Filed At. _____

Object Ident. _____

Ident. By _____

Signature

PLANE COORDINATE POSITION DATA

State _____ Zone _____

X _____

Y _____

Estab. By _____

Agency

Signature

Title

Division

Headquarters

Date

7100-52 (3-68)

Aue Hewstetter

Civil Eng Tech SO

6/25/84

CORNER RECORD (PERPETUATION)

MONUMENT : DESCRIBE NEW MONUMENT SET, OR WORK DONE TO PRESERVE EXISTING MONUMENT

ACCESSORIES : DESCRIBE NEW BT'S WITNESS OBJECTS ETC. ESTABLISHED, OR WORK DONE TO PRESERVE EXISTING EVIDENCE

Work Done By _____ Title _____ Date _____ State Registration No. _____
or Agency _____

Certified Cor. Record Prepared ? Yes No Filed At: _____ Date _____

REMARKS

Index File No. T. R. M. Tract or Surv. No. Cor.

Index
File No. Z-15

CORNER RECORD (SEARCH)

(Ref. FSM 7151.4)

Tract or Survey No. _____ Cor. No. Z-15


T 4 N R. 38 E

R.D. Walla Walla County _____

Merid. Willamette

N.F. Umatilla State Oregon

CORNER DIAGRAM

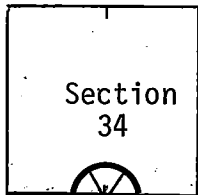

DESCRIBE CORNER MONUMENT FOUND

Material: Basalt stone. Size: 12" x 10" x 5".

0' above ground; good condition; no markings visible.

DESCRIBE BEARING TREES OR OTHER OFFICIAL ACCESSORIES FOUND

40" spruce bears S 74° W, approximately 45' distance, blazed on northeast face. Blaze is chopped out with what appears to be scribing at top of hole.

24" fir bears N 18° W, 11' distance from stone. Fir is blazed on southeast face and scribed: ¼ S 34 B.T. (not in my notes). No sign of B.T. northeast quadrant.

PHOTO IDENTIFICATION DATA

Photo No. _____

Filed At. _____

Object Ident. _____

Ident. By _____

Signature

PLANE COORDINATE POSITION DATA

State _____ Zone _____

X _____

Y _____

Estab. By _____

Agency

Signature

B, Moore

Title

Engineering Technician

Division

Headquarters

S, O.

Date

August 1975

7100-52 (3/68)

CORNER RECORD (PERPETUATION)

MONUMENT: DESCRIBE NEW MONUMENT SET, OR WORK DONE TO PRESERVE EXISTING MONUMENT

9

ACCESSORIES : DESCRIBE NEW BT'S WITNESS OBJECTS ETC. ESTABLISHED, OR WORK DONE TO PRESERVE EXISTING EVIDENCE

Blazed line leads to corner east-west.

I placed a Forest Service blank B.T. poster on each bearing tree.

10

Work Done By _____ Title _____ Date _____ State Registration No. or Agency _____

Certified Cor. Record Prepared ? Yes No Filed At: _____ Date _____ 11

REMARKS

12

Index File No. T. R. M. Tract or Surv. No. Cor. 13