

CERTIFIED RECORD OF LAND CORNER MONUMENTATION


E - 19
DIAGRAM

History of original corner establishment:

The original corner was established by George S. Pershin on June 14, 1882, under GLO contract No. 430, as follows:

A pine, 20" in diameter on a south slope near a brook, for 1/4 section corner to sections 2 and 11, marked 1/4 on the north side, from which:

- A 22" pine, marked "1/4 S BT", bears N31° W, 18 links (11.88 feet).
- A 10" pine, marked "1/4 S BT", bears S60° E, 49 links (32.34 feet).

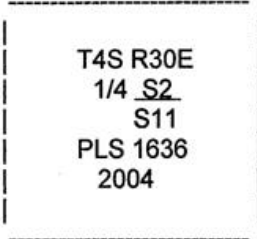

Original corner evidence recovered:

The original corner tree is uprooted and slid down hill to Patty Creek. This tree has deep axe marks and burnt out blaze.

The broken stump of the original north west bearing tree, with the badly decayed remains of the tree lying down slope, bears N 31° W, 11.9 feet. No marks remain on this tree. The original bearing tree to the southeast is gone.


Monument and accessories established to perpetuate the original position of this corner:

At record bearing and distance from the broken stump of the original northwest bearing tree, I set a 1" x 30" flared, galvanized iron pipe 26" into the ground. A 2 1/2" brass cap attached to the top of the pipe is marked as shown in the diagram above. I build a mound of stones around the pipe, from which:

- A 5/8" x 24" iron rod, set 23" into the ground with a 3/4" brass washer, marked "PLS 1636 S2", attached at ground level, bears N69° E, 74.1 feet.
- A 22" Douglas-fir, scribed "1/4 S11 BT", bears S76° E, 86.5 feet.
- A 5/8" x 24" iron rod, set 23" into the ground with a 3/4" brass washer, marked "PLS 1636 11" attached at ground level, bears S72° 30' W, 50.8 feet.
- A 16" Ponderosa Pine, scribed "1/4 S2 BT", bears N64° W, 55.3 feet. I nail a "Bearing Object" sign above the blazes.

The new bearing trees are scribed on double blazes and have a 3/4" brass washer, marked "PLS 1636", nailed flush to the scribed "B".

I hereby certify the above corner point was perpetuated as hereon described on April 7, 2004. Magnetic declination set in compass: 18° E.
NAD '83 UTM Zone 11 position: 5011949N, 338712E (plus or minus two meters).

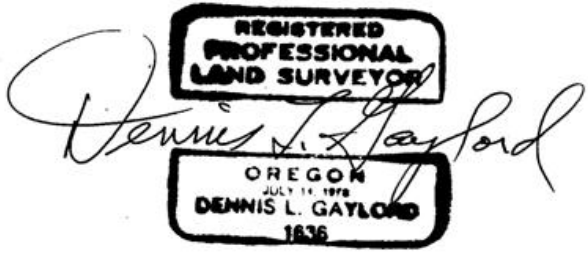

Renews June 30, 2005

Recorded at the office of County Surveyor, County of Umatilla, State of Oregon, on:

RECEIVED BY
 Umatilla County Surveyor
 Date 05-04
 Rec'd By KK
 No. 04-95-R