

USDA-FOREST SERVICE

Index File No. J-19

CORNER RECORD (SEARCH)

(Ref. FSM 7151.4)

Tract or Survey No. _____ Cor. No. _____

T 4S R: 30E R.D. Ukiah County Umatilla

Merid. Willamette N.F. Umatilla State Oregon

CORNER DIAGRAM



T4S R30E

1/4 $\frac{511}{514}$

1981
PLS 848

DESCRIBE CORNER MONUMENT FOUND

Found 13"x11"x9" basalt stone set in ground with 1/4 on North face.

DESCRIBE BEARING TREES OR OTHER OFFICIAL ACCESSORIES FOUND

A mound of stone East alongside.

PHOTO IDENTIFICATION DATA

Photo No. _____
 Filed At. _____
 Object Ident. _____
 Ident. By _____
 Signature _____

DESCRIBE CORNER LOCATION RELATIVE TO NEAR-BY FEATURES, ALSO HOW TO REACH CORNER

Corner is on SW slope on open ridge, approximately 800 ft. North of draw bottom.

PLANE COORDINATE POSITION DATA

State _____ Zone _____
 X _____
 Y _____
 Estab. By _____
 Agency _____

Signature _____

Title _____ Division _____ Headquarters _____ Date _____
 PLS 848 Mt. Vernon, OR 7/31/81 7100-52-(3:68)

CORNER RECORD (PERPETUATION)

MONUMENT: DESCRIBE NEW MONUMENT SET, OR WORK DONE TO PRESERVE EXISTING MONUMENT

Set 3"x30" galv.iron pipe with 3" brass cap, stamped as shown on the diagram, set 16" in the ground and raised a mound of stone around the pipe.

ACCESSORIES : DESCRIBE NEW BT's WITNESS OBJECTS ETC. ESTABLISHED, OR WORK DONE TO PRESERVE EXISTING EVIDENCE

No bearing trees available.
Set a steel post with warning sign 5 ft. North from corner.

Work Done By D.M. Ferguson Title Surveyor Date 7/31/81 State Registration No. OR PLS 848
or Agency

Certified Copy Prepared? Yes No Filed At: Umatilla Co. Surveyor Office Date 10/81

PROFESSIONAL
LAND SURVEYOR

REMARKS

Witnesses to above corner:
D. Mitchell Ferguson
Mike Woodward

OREGON
JULY 12, 1968
DOUGLAS M. FERGUSON
848

Index File No.

T.
45

R.
30E

M.

Tract or Surv. No.

Cor.

13


Index
 File No. J-19
 T 4S R. 30E
 Merid. Willamette

CORNER RECORD (SEARCH)
 (Ref. FSM 7151.4)

Tract or
 Survey No. 4-145 Cor. No. J-19

R.D. Ukiah County Umatilla
 N.F. Umatilla State Oregon

CORNER DIAGRAM

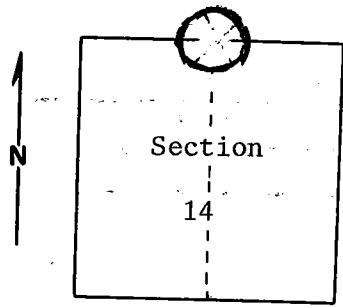

DESCRIBE CORNER MONUMENT FOUND

Material: Stone mound. Size: Mound has 3 foot diameter.
 12 inches above ground; fair condition.

Cannot identify corner stone.

DESCRIBE BEARING TREES OR OTHER OFFICIAL ACCESSORIES FOUND

There is evidence of an old fence corner here. Very rotten posts on the ground indicate fence once ran west and north from corner. There were no original B.T.'s. Non available. Location is in a very large prairie.

PHOTO IDENTIFICATION DATA

Photo No. _____
 Filed At. _____
 Object Ident. _____
 Ident. By _____
 Signature _____

DESCRIBE CORNER LOCATION RELATIVE TO NEAR-BY FEATURES, ALSO HOW TO REACH CORNER

There is a lone, scrubby 20-foot high p.pine which bears N5°W from mound approximately 200 feet.

PLANE COORDINATE POSITION DATA

State _____ Zone _____
 X _____
 Y _____
 Estab. By _____
 Agency _____

Bottom of drainage (at edge of timber) is about 500 feet south.

Signature T. Hollamon Title Engineering Technician Division _____ Headquarters S. O. Date May 31, 1974 7100-52-(3/68)

2

CORNER RECORD (PERPETUATION)

MONUMENT: DESCRIBE NEW MONUMENT SET, OR WORK DONE TO PRESERVE EXISTING MONUMENT

9

ACCESSORIES : DESCRIBE NEW BT's WITNESS OBJECTS ETC. ESTABLISHED, OR WORK DONE TO PRESERVE EXISTING EVIDENCE.

I piled several of the old posts on the stone mound. Look for this. It should be visible for some distance.

10

Work Done By _____ Title _____ Date _____ State Registration No. _____
or Agency _____

Certified Cor. Record Prepared ? Yes No Filed At: _____ Date _____ 11

REMARKS

12

Index File No. T. R. M. Tract or Surv. No. Cor. 13