

Index  
 File No. J-20  
 T 45 R. 30E  
 Merid. Willamette


CORNER RECORD (SEARCH)

(Ref. FSM 7151.4)

Tract or  
 Survey No. \_\_\_\_\_ Cor.  
 No. \_\_\_\_\_

R.D. Ukiah County Umatilla  
 N.F. Umatilla State Oregon

CORNER DIAGRAM

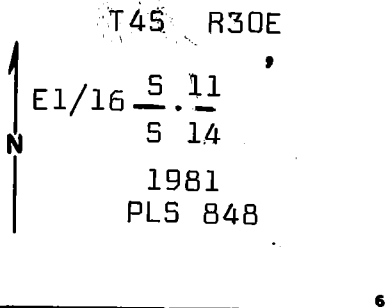

DESCRIBE CORNER MONUMENT FOUND

Corner not previously established.

DESCRIBE BEARING TREES OR OTHER OFFICIAL ACCESSORIES FOUND

N/A

PHOTO IDENTIFICATION DATA

Photo No. \_\_\_\_\_  
 Filed At. \_\_\_\_\_  
 Object Ident. \_\_\_\_\_  
 Ident. By \_\_\_\_\_  
*Signature*

PLANE COORDINATE POSITION DATA

State \_\_\_\_\_ Zone \_\_\_\_\_  
 X \_\_\_\_\_  
 Y \_\_\_\_\_  
 Estab. By \_\_\_\_\_  
*Agency*

DESCRIBE CORNER LOCATION RELATIVE TO NEAR-BY FEATURES, ALSO HOW TO REACH CORNER

Corner is on South slope of open ridge approx.  
 1/4 mile West from primitive road, coursing N-E.

*Signature*  
 Signature

Title PLS 848 Division Mt. Vernon, DR Headquarters 8/4/81 Date 7100-52-(3/68)

**CORNER RECORD (PERPETUATION)**

**MONUMENT: DESCRIBE NEW MONUMENT SET, OR WORK DONE TO PRESERVE EXISTING MONUMENT**

Set 3"x30" galv. iron pipe with 3" brass cap, set 12" in the ground and raised a mound of stone around pipe. Stamped brass cap as shown on the diagram.

**ACCESSORIES : DESCRIBE NEW BT'S WITNESS OBJECTS ETC. ESTABLISHED, OR WORK DONE TO PRESERVE EXISTING EVIDENCE**

Set steel posts with warning and bounday signs 6 ft. South and 8 ft. West from corner.

Work Done By D.M. Ferguson Title Surveyor Date 8/4/81 State Registration No. OR PLS 848  
or Agency

Certified Cor. Record Prepared Yes  No  Filed At: Umatilla Co. Surv. Office Date 10/81

**PROFESSIONAL  
LAND SURVEYOR**

**REMARKS**

Witnesses: D. Mitchell Ferguson  
Mike Woodward

**OREGON  
JULY 12, 1968  
DOUGLAS M. FERGUSON  
848**