

Index

File No. J-23

CORNER RECORD (SEARCH)

(Ref. FSM 7151.4)

Tract or

Survey No. \_\_\_\_\_

Cor.

No. \_\_\_\_\_


T. 4S R. 30E

R.D. UKIAM County UMATILLA

Merid. WILL

N.F. UMATILLA State OREGON

CORNER DIAGRAM

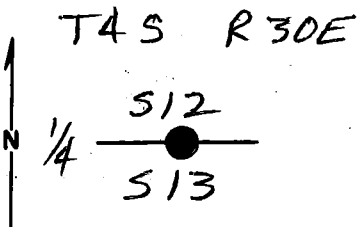

DESCRIBE CORNER MONUMENT FOUND

ORIGINAL CORNER STONE MARKED "1/4"  
ON NORTH FACE

DESCRIBE BEARING TREES OR OTHER OFFICIAL ACCESSORIES FOUND

NONE

PHOTO IDENTIFICATION DATA

Photo No. \_\_\_\_\_

Filed At. \_\_\_\_\_

Object Ident. \_\_\_\_\_

Ident. By \_\_\_\_\_

Signature

PLANE COORDINATE POSITION DATA

State \_\_\_\_\_ Zone \_\_\_\_\_

X \_\_\_\_\_

Y \_\_\_\_\_

Estab. By \_\_\_\_\_

Agency

Signature

Title

Division

Headquarters

Date

Dennis J. Laybold

PLS 1636

1-19-81

7100-52-(3/68)

CORNER RECORD (PERPETUATION)

MONUMENT: DESCRIBE NEW MONUMENT SET, OR WORK DONE TO PRESERVE EXISTING MONUMENT

2 1/2" x 30" IRON PIPE W/ 3" BRASS CAP MKD:

T4S R30E

1/4 512  
513

PLS 1636

ACCESSORIES: DESCRIBE NEW BT'S WITNESS OBJECTS ETC. ESTABLISHED, OR WORK DONE TO PRESERVE EXISTING EVIDENCE

23" POND. PINE BEAR > N50°E, 66' ft SCRIBED "1/4 512 BT"

13" POND. PINE BEAR > S48°30'E, 59' ft, SCRIBED "1/4 513 BT"

Work Done By: Dennis Taylor

Date 1-19-81 State Registration No. PLS 1636  
or Agency

Certified Cor. Record Prepared?  Yes  No

Filed At: UMATILLA CO.

Date 1-26-81

REMARKS

Index File No.

J-23

T.

4S

R.

30E

M.

WIL

Tract or Surv. No.

Cor.

12

13

Index File No. J-23

**CORNER RECORD (SEARCH)**  
(Ref. FSM 7151.4)

Tract or Survey No. 4-144 Cor. No. J-23


T 4S R. 30E

R.D. Ukiah County Umatilla

Merid. Willamette

N.F. Umatilla State Oregon

**CORNER DIAGRAM**

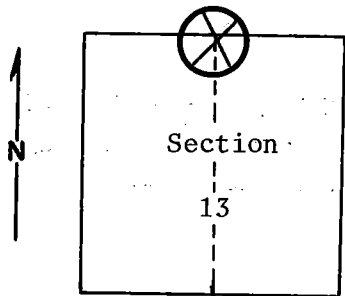

**DESCRIBE CORNER MONUMENT FOUND**

Material: Basalt stone. Size: 15" x 8" x 5".

6 inches above ground; fair condition. No markings visible. Stone sets in circle of smaller stones.

**DESCRIBE BEARING TREES OR OTHER OFFICIAL ACCESSORIES FOUND**

A 14-inch p.pine (double boled) bears east about 80 to 90 feet. It has a "Bureau of Land Management" aluminum location poster and a "Harris Pine" aluminum location poster on it.

**PHOTO IDENTIFICATION DATA**

Photo No. \_\_\_\_\_  
Filed At. \_\_\_\_\_  
Object Ident. \_\_\_\_\_  
Ident. By \_\_\_\_\_  
*Signature*

**PLANE COORDINATE POSITION DATA**

State \_\_\_\_\_ Zone \_\_\_\_\_  
X \_\_\_\_\_  
Y \_\_\_\_\_  
Estab. By \_\_\_\_\_  
*Agency*

**DESCRIBE CORNER LOCATION RELATIVE TO NEAR-BY FEATURES, ALSO HOW TO REACH CORNER**

There is an old east-west road along the ridge top approximately 200 feet south of  $\frac{1}{4}$  corner.

Signature T. Hollamon Title Engineering Technician Division S. O. Headquarters S. O. Date May 31, 1974 7100-52-(3/68)

CORNER RECORD (PERPETUATION)

MONUMENT: DESCRIBE NEW MONUMENT SET, OR WORK DONE TO PRESERVE EXISTING MONUMENT

8

ACCESSORIES : DESCRIBE NEW BT's WITNESS OBJECTS ETC. ESTABLISHED, OR WORK DONE TO PRESERVE EXISTING EVIDENCE

9

I placed a location poster on a scrubby 6-inch p.pine approximately 150 feet south of the stone mound (50 feet north of road).

10

Work Done By \_\_\_\_\_ Title \_\_\_\_\_ Date \_\_\_\_\_ State Registration No. \_\_\_\_\_ or Agency \_\_\_\_\_  
Certified Cor. Record Prepared ? Yes No Filed At: \_\_\_\_\_ Date \_\_\_\_\_

11

REMARKS

12

Index File No. T. R. M. Tract or Surv. No. Cor. 13