

USDA-FOREST SERVICE

Index File No. K-24

CORNER RECORD (SEARCH)

(Ref. FSM 7151.4)

Tract or Survey No. _____ Cor. No. _____

T 45 R. 30E

R.D. Ukiah County Umatilla

Merid. Willamette

N.F. Umatilla State Oregon

CORNER DIAGRAM

T45 R30E

NE 1/16 S 13

1981

PLS 848



DESCRIBE CORNER MONUMENT FOUND

Corner not previously established.

DESCRIBE BEARING TREES OR OTHER OFFICIAL ACCESSORIES FOUND

N/A

PHOTO IDENTIFICATION DATA

Photo No. _____

Filed At. _____

Object Ident. _____

Ident. By _____

Signature

PLANE COORDINATE POSITION DATA

State _____ Zone _____

X _____

Y _____

Estab. By _____

Agency

DESCRIBE CORNER LOCATION RELATIVE TO NEAR-BY FEATURES, ALSO HOW TO REACH CORNER

Corner is on top of a flat open ridge just NE of a road coursing SE.

Title _____ Division _____ Headquarters _____ Date _____

PLS 848

Mt. Vernon, OR

8/5/81

7100-52-(3/68)

CORNER RECORD (PERPETUATION)

MONUMENT: DESCRIBE NEW MONUMENT SET, OR WORK DONE TO PRESERVE EXISTING MONUMENT

Set 3"x30" iron pipe with 3" brass cap stamped as shown on the diagram, set 14 inches in the ground and raised a mound of stone around the pipe.

From which:

ACCESSORIES : DESCRIBE NEW BT's WITNESS OBJECTS ETC. ESTABLISHED, OR WORK DONE TO PRESERVE EXISTING EVIDENCE


A juniper 10 inches dia. bears S64°W, 9.5 ft. scribed NE 1/16.S 13.BT. No other tree available.

Set steel posts with warning and boundary signs 5 ft. North and 5 ft. East from corner.


Nailed bearing tree signs and brass washers stamped PLS 848 to tree. Painted a red band around tree.

Work Done By D.M. Ferguson Title Surveyor Date 8/5/81 State Registration No. OR PLS 848
or Agency

Certified For Record Prepared? Yes No Filed At: Umatilla Co. Surveyor Date

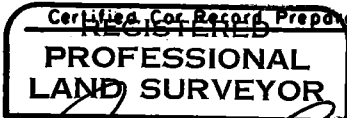

REMARKS

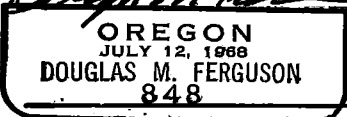

Index File No.

R.

M.

Tract or Surv. No.

Cor.

13