

USDA-FOREST SERVICE


Index
File No. K-25
T 45 R30 & 31E
Merid. Willamette

CORNER RECORD (SEARCH)

(Ref. FSM 7151.4)

Tract or Survey No. _____ Cor. No. _____
R.D. Ukiah County Umatilla
N.F. Umatilla State Oregon

CORNER DIAGRAM

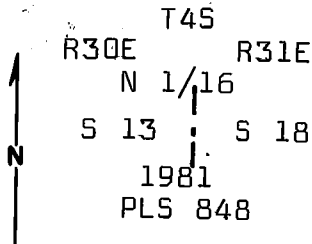

DESCRIBE CORNER MONUMENT FOUND

Corner not previously established.

DESCRIBE BEARING TREES OR OTHER OFFICIAL ACCESSORIES FOUND

N/A

PHOTO IDENTIFICATION DATA

Photo No. _____
Filed At. _____
Object Ident. _____
Ident. By _____
Signature

PLANE COORDINATE POSITION DATA

State _____ Zone _____
X _____
Y _____
Estab. By _____
Agency

DESCRIBE CORNER LOCATION RELATIVE TO NEAR-BY FEATURES, ALSO HOW TO REACH CORNER

Corner on level ground in open pine timber.
E-W fence approx. 5 ft. South.
N-S fence approx. 40 ft. West; fence
corner 40 ft. West.

Signature

Title
PLS 848

Division

Headquarters
Mt. Vernon, OR

Date
8/5/81

7100-52-(3/68)

