

USDA-FOREST SERVICE

Index File No. L-23

T 4S R. 30E

Merid. Willamette

CORNER-RECORD (SEARCH)


(Ref. FSM 7151.4)

R.D. Ukiah County Umatilla

N.F. Umatilla State Oregon

Tract or Survey No. _____ Cor. No. _____

CORNER DIAGRAM

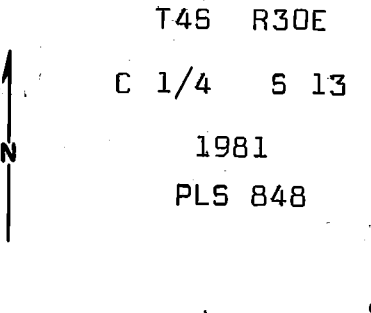

DESCRIBE CORNER MONUMENT FOUND

Corner not previously established.

DESCRIBE BEARING TREES OR OTHER OFFICIAL ACCESSORIES FOUND

N/A

PHOTO IDENTIFICATION DATA

Photo No. _____
 Filed At. _____
 Object Ident. _____
 Ident. By _____
Signature

PLANE COORDINATE POSITION DATA

State _____ Zone _____
 X _____
 Y _____
 Estab. By _____
Agency

DESCRIBE CORNER LOCATION RELATIVE TO NEAR-BY FEATURES, ALSO HOW TO REACH CORNER

Corner is on an East slope in pine timber approx. 700 ft. East from a primitive road. To reach corner, go East approx. 700 ft. from road where the road goes through a gate.

Signature

Title PLS 848 Division _____ Headquarters Mt. Vernon, OR Date 8/6/81
 7100-52 (3-68)

CORNER RECORD (PERPETUATION)

MONUMENT: DESCRIBE NEW MONUMENT SET, OR WORK DONE TO PRESERVE EXISTING MONUMENT

Set 3"x30" galv. iron pipe with 3" brass cap stamped as shown on the diagram. Set pipe 20 inches in the ground and placed a ring of stone around the pipe.

From which:

ACCESSORIES: DESCRIBE NEW BT'S WITNESS OBJECTS ETC. ESTABLISHED, OR WORK DONE TO PRESERVE EXISTING EVIDENCE

A pine 8 inches dia. bears N21°E, 22.0 ft. Scribed C 1/4 S 13 BT.
A pine 10 inches dia. bears S82°W, 15.7 ft. scribed C 1/4 S 13 BT.
Set steel posts with warning and boundary signs 5 ft. North and 5 ft. East from corner.
Nailed bearing tree signs and brass washers stamped PLS 848 to each tree.
Painted a red band around each tree.

Work Done By D.M. Ferguson Title Surveyor Date 8/6/81 State Registration No. or Agency OR PLS 848

Certified Correctly Prepared? Yes No Filed At: Umatilla Co. Surveyor Off Date

PROFESSIONAL
LAND SURVEYOR

OREGON
JULY 12, 1968
DOUGLAS M. FERGUSON
848

REMARKS

Witnesses to above corner:
D. Mitchell Ferguson
Mike Woodward