

USDA-FOREST SERVICE

Index File No. 0-19

CORNER RECORD (SEARCH)

(Ref. FSM 7151.4)

Tract or Survey No. _____ Cor. No. _____


T 4S R. 30E

R.D. Ukiah County Umatilla

Merid. Willamette

N.F. Umatilla State Oregon

CORNER DIAGRAM

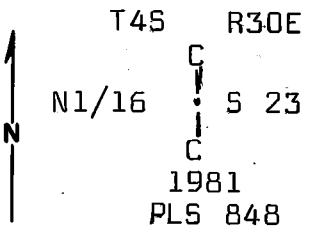

DESCRIBE CORNER MONUMENT FOUND

Not previously established.

DESCRIBE BEARING TREES OR OTHER OFFICIAL ACCESSORIES FOUND

N/A

PHOTO IDENTIFICATION DATA

Photo No. _____
 Filed At. _____
 Object Ident. _____
 Ident. By _____
Signature

DESCRIBE CORNER LOCATION RELATIVE TO NEAR-BY FEATURES, ALSO HOW TO REACH CORNER

From the C 1/4 Sec. 23 a road leads from the ridge road 1/4 mile. Corner is approximately 200 ft. East of road on level ground.

PLANE COORDINATE POSITION DATA

State _____ Zone _____
 X _____
 Y _____
 Estab. By _____
Agency

Signature

Title PLS 848 Division _____ Headquarters Mt. Vernon, OR Date 8/12/81
 7100-52-(3/68)

6

2

3

4

5

CORNER RECORD (PERPETUATION)

MONUMENT: DESCRIBE NEW MONUMENT SET, OR WORK DONE TO PRESERVE EXISTING MONUMENT

Set 3"x30" galv. iron pipe with 3" brass cap, stamped as shown in the diagram, set 20 in. in the ground.

From which:

ACCESSORIES : DESCRIBE NEW BT's WITNESS OBJECTS ETC. ESTABLISHED, OR WORK DONE TO PRESERVE EXISTING EVIDENCE

A pine 20 in. dia. bears S71°E, 14.2 ft. scribed C N 1/16 S 23 BT.
A pine 12 in. dia. bears S 52°W, 31.2 ft. scribed C N 1/16 S 23 Bt.
Set steel posts with warning and boundary signs 5 ft. East and 5 ft. North from corner.
Nailed bearing tree signs and brass washers stamped PLS 848 to each tree.
Painted a red band around each tree.

Work Done By D.M. Ferguson Title Surveyor Date 8/12/81 State Registration No. OR PLS 848
or Agency

Certified Copy Record Prepared? Yes No Filed At: Umatilla Co. Surv. Off. Date 10/81

**PROFESSIONAL
LAND SURVEYOR**

REMARKS

Witnesses to above corner:

D. Mitchell Ferguson
Mike Woodward

OREGON
JULY 12, 1968
DOUGLAS M. FERGUSON
848