

USDA-FOREST SERVICE

Index File No. P-21

CORNER RECORD (SEARCH)

(Ref. FSM 7151.4)

Tract or Survey No. _____ Cor. No. _____

T 45 R 30E

R.D. Ukiah County Umatilla

Merid. Willamette

N.F. Umatilla State Oregon

CORNER DIAGRAM

T45 R30E

1/4

523 | 524

1981

PLS 848



DESCRIBE CORNER MONUMENT FOUND

Found basalt stone 12"x10"x8" set in mound of stone. 1/4 on West face.

DESCRIBE BEARING TREES OR OTHER OFFICIAL ACCESSORIES FOUND

No evidence of original bearing trees. Accepted center of 12"x10"x8" stone as the 1/4 corner position.

PHOTO IDENTIFICATION DATA

Photo No. _____

Filed At. _____

Object Ident. _____

Ident. By _____

Signature

PLANE COORDINATE POSITION DATA

State _____ Zone _____

X _____

Y _____

Estab. By _____

Agency

DESCRIBE CORNER LOCATION RELATIVE TO NEAR-BY FEATURES, ALSO HOW TO REACH CORNER

Primitive road, N-S, lies approx. 200 ft. West and primitive road, E-W, lies approx. 300 ft. North.

Signature

Title PLS 848 Division _____ Headquarters Mt. Vernon, OR Date 7/2/81 7100-52-(3:68)

CORNER RECORD (PERPETUATION)

MONUMENT: DESCRIBE NEW MONUMENT SET, OR WORK DONE TO PRESERVE EXISTING MONUMENT

Set 3"x30" galv. iron pipe with 3" brass cap, stamped as shown on the diagram. Set 16" in the ground and raised a mound of stone and earth around the pipe.

From which:

ACCESSORIES: DESCRIBE NEW BT'S WITNESS OBJECTS ETC. ESTABLISHED, OR WORK DONE TO PRESERVE EXISTING EVIDENCE

A pine 9 in. dia. bears N3°W, 35.2 ft. scribed 1/4 S 2~~4~~ BT.
A pine 10 in. dia. bears N74°E, 25.9 ft. scribed 1/4 S 2~~4~~ BT.
Set steel posts with warning and boundary signs 5 ft. North and 5 ft. East from corner.
Nailed bearing tree signs and brass washers stamped PLs 848 to each tree.
Painted red band around each tree.

Work Done By D.M. Ferguson Title Surveyor Date 7/2/81 State Registration No. or Agency OR PLS 848

Certificate of Record Prepared? Yes No Filed At: Umatilla Co. Surveyor's office Date 10/81

REGISTERED
PROFESSIONAL
LAND SURVEYOR

REMARKS

Witnesses to above corner:
D. Mitchell Ferguson
Dave Herburger

D. M. Ferguson
OREGON
JULY 12, 1968
DOUGLAS M. FERGUSON
848

USDA-FOREST SERVICE

Index
File No. P-21
T 4 S R. 30 E
Merid. W.M.


CORNER RECORD (SEARCH)

(Ref. FSM 7151.4)

Tract or Survey No. _____
Cor. No. P-21

R.D. UKIAH County UMATILLA
N.F. UMATILLA State OREGON

CORNER DIAGRAM

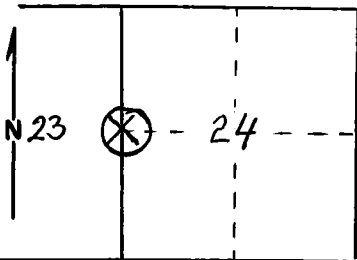

DESCRIBE CORNER MONUMENT FOUND

Found a mound of stone with one large stone in the center about 8" in the ground, with $\frac{1}{4}$ marked on the stone. The mound of stone is on a east slope.

DESCRIBE BEARING TREES OR OTHER OFFICIAL ACCESSORIES FOUND

Found a 24" pine, down with $\frac{1}{4}$ S BT scribed on the tree. The tree has fallen on the scribe. The B.T. if standing, would bear N44°W 50LKS. as described in the G.L.O. notes. The other B.T. was not found. A old location poster is on a tree about 5 ft. from the corner.


PHOTO IDENTIFICATION DATA

Photo No. _____
Filed At. _____
Object Ident. _____
Ident. By _____
Signature

PLANE COORDINATE POSITION DATA

State _____ Zone _____
X _____
Y _____
Estab. By _____
Agency

DESCRIBE CORNER LOCATION RELATIVE TO NEAR-BY FEATURES, ALSO HOW TO REACH CORNER

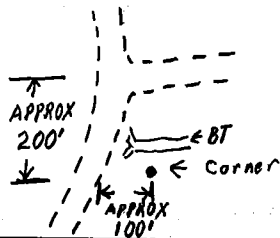

Signature

Title

Division

Headquarters

Date

7100-52-(3/68)

Danny Evans

Civil Eng Tech Eng

Ukiah

July 2 1979

CORNER RECORD (PERPETUATION)

MONUMENT : DESCRIBE NEW MONUMENT SET, OR WORK DONE TO PRESERVE EXISTING MONUMENT

ACCESSORIES : DESCRIBE NEW BT'S WITNESS OBJECTS ETC. ESTABLISHED, OR WORK DONE TO PRESERVE EXISTING EVIDENCE

Work Done By _____ Title _____ Date _____ State Registration No. or Agency _____
Certified Cor. Record Prepared ? Yes No Filed At: _____ Date _____

REMARKS