

Index File No. U-22

CORNER RECORD (SEARCH)

(Ref. FSM 7151.4)

Tract or Survey No. _____ Cor. No. _____

T 45 S R. 30E

R.D. Ukiah County Umatilla

Merid. Willamette

N.F. Umatilla State Oregon

CORNER DIAGRAM



T45 R30E

SW 1/16 S 25

1981

PLS 848

DESCRIBE CORNER MONUMENT FOUND

Corner not previously established.

DESCRIBE BEARING TREES OR OTHER OFFICIAL ACCESSORIES FOUND

N/A

PHOTO IDENTIFICATION DATA

Photo No. _____

Filed At. _____

Object Ident. _____

Ident. By _____

Signature

DESCRIBE CORNER LOCATION RELATIVE TO NEAR-BY FEATURES, ALSO HOW TO REACH CORNER

Corner on gradual North-West slope on open ground.

PLANE COORDINATE POSITION DATA

State _____ Zone _____

X _____

Y _____

Estab. By _____

Agency

Signature

Title PLS 848

Division _____

Headquarters Mt. Vernon, OR

Date 7/30/81

7100-52-(3.68)

CORNER RECORD (PERPETUATION)

MONUMENT: DESCRIBE NEW MONUMENT SET, OR WORK DONE TO PRESERVE EXISTING MONUMENT

Set 3"x30" galv. iron pipe with 3" brass cap stamped as shown on the diagram. Set pipe 18 inches in ground and raised a mound of stone around the pipe.


From which:

ACCESSORIES: DESCRIBE NEW BT'S WITNESS OBJECTS ETC. ESTABLISHED, OR WORK DONE TO PRESERVE EXISTING EVIDENCE

A pine 13 inches dia. bears N52°E, 103.0 ft. scribed SW 1/16 S 25 BT.
A pine 12 inches dia. bears S79°W, 201.2 ft. scribed SW 1/16 S 25 BT.
Set steel posts with warning and boundary signs 5 ft. East and 5 ft. North from corner.
Nailed bearing tree signs and brass washers stamped PLS 848 to each tree.
Painted red band around each tree.

Work Done By D.M. Ferguson Title Surveyor Date 7/30/81 State Registration No. OR PLS 848
or Agency

Certified Registered? Yes No Filed At: Umatilla Co. Surveyor Off Date

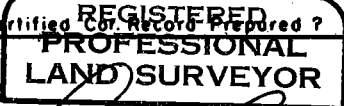

REMARKS

Witnesses to above corner:

D. Mitchell Ferguson
Mike Woodward