

Index  
File No. V-21


**CORNER RECORD (SEARCH)**

(Ref. FSM 7151.4)

Tract or Survey No. 4-147 Cor. No. V-21

T 4S R. 30E R.D. Ukiah County Umatilla  
Merid. Willamette N.F. Umatilla State Oregon

**CORNER DIAGRAM**

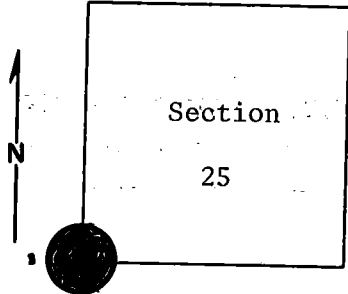

**DESCRIBE CORNER MONUMENT FOUND**

Material: Basalt stone. Size: 15" x 10" x 5".  
*Monumented By BLM, 1978*  
10 inches (loose) above ground; fair condition. Markings are not clear. Sets in stone mound in east-west fence line.

**DESCRIBE BEARING TREES OR OTHER OFFICIAL ACCESSORIES FOUND**

- A 21-inch rotting p.pine stump bears N80°E, approximately 64 feet. Some scribing visible.
  - A 24-inch p.pine bears S57°E, approximately 50 feet. Scribing visible. It has old "Attention" tag.
  - A 30-inch p.pine bears S48°W, approximately 30 feet. Scribing visible. It has old "Attention" poster and old location poster.
- An old rotting p.pine stump bears (cont. in block 12.)

**DESCRIBE CORNER LOCATION RELATIVE TO NEAR-BY FEATURES, ALSO HOW TO REACH CORNER**

Approximately 300 feet north of corner is a primitive road which runs NE by SW.

**PHOTO IDENTIFICATION DATA**

Photo No. \_\_\_\_\_  
Filed At. \_\_\_\_\_  
Object Ident. \_\_\_\_\_  
Ident. By \_\_\_\_\_

*Signature*

**PLANE COORDINATE POSITION DATA**

State \_\_\_\_\_ Zone \_\_\_\_\_  
X \_\_\_\_\_  
Y \_\_\_\_\_  
Estab. By \_\_\_\_\_  
*Agency*

Signature T. Hollamon Title Engineering Technician Division \_\_\_\_\_ Headquarters S. O. Date June 10, 1974 7100-52-(3/68)

CORNER RECORD (PERPETUATION)

MONUMENT: DESCRIBE NEW MONUMENT SET, OR WORK DONE TO PRESERVE EXISTING MONUMENT

9

ACCESSORIES : DESCRIBE NEW B.T.'s WITNESS OBJECTS ETC. ESTABLISHED, OR WORK DONE TO PRESERVE EXISTING EVIDENCE

I placed blank B.T. tags on the two B.T.'s and also on the two old B.T. stumps.  
I also placed a location poster on the north side of a 10-inch p.pine at south edge of road about 300 feet north of corner.

10

Work Done By \_\_\_\_\_ Title \_\_\_\_\_ Date \_\_\_\_\_ State Registration No. or Agency \_\_\_\_\_

Certified Cor. Record Prepared ? Yes No Filed At: \_\_\_\_\_ Date \_\_\_\_\_

11

REMARKS

(Block #3, cont.)

N77°W, approximately 55 feet. Some scribing still visible.

A 12-inch p.pine bears south about 25 feet. It has a 12-inch high  $\text{R}$  brand (SR) on the north face.

12

Index File No. T. R. M. Tract or Surv. No. Cor. \_\_\_\_\_

13