

Index  
File No. A-19

**CORNER RECORD (SEARCH)**

(Ref. FSM 7151.4)

Tract or Survey No. Sec 2 Cor. No. N 1/4


T 4S R. 31E

R.D. Ukiah County Umatilla

Merid. Willamette

N.F. Umatilla State Oregon

**CORNER DIAGRAM**

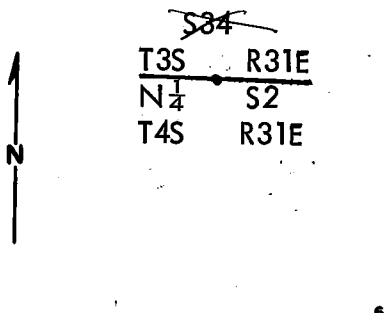

**DESCRIBE CORNER MONUMENT FOUND**

None.

**DESCRIBE BEARING TREES OR OTHER OFFICIAL ACCESSORIES FOUND**

None.

**PHOTO IDENTIFICATION DATA**

Photo No. \_\_\_\_\_  
 Filed At. \_\_\_\_\_  
 Object Ident. \_\_\_\_\_  
 Ident. By \_\_\_\_\_  
*Signature*

**DESCRIBE CORNER LOCATION RELATIVE TO NEAR-BY FEATURES, ALSO HOW TO REACH CORNER**

Road #5420 to road #5412-100, then West on road #5412-100 approx. 1.4 miles to road fork South through gate, then South and West to road fork approx. 0.4 mile across open meadow, then South at fork to E 1/16 corner section 2, then West along E-W fence through canyon and to top of ridge at corner on steep South slope in sparse timber.

**PLANE COORDINATE POSITION DATA**

State \_\_\_\_\_ Zone \_\_\_\_\_  
 X \_\_\_\_\_  
 Y \_\_\_\_\_  
 Estab. By \_\_\_\_\_  
*Agency*

Signature

Title

Division

Headquarters

Date

7100-52-(3,68)

PLS 1106

October 21, 1982

CORNER RECORD (PERPETUATION)

MONUMENT: DESCRIBE NEW MONUMENT SET, OR WORK DONE TO PRESERVE EXISTING MONUMENT

Set 2 1/2" brass cap on 2 1/2" x 30" l. pipe 16" in ground with mound of stone.

Set steel fence post with 54-2 and 4 signs attached, West of corner. Cap marked:

~~534~~  
T3S R31E  
N 1/4 S2  
T4S R31E  
1982  
PLS 1106

ACCESSORIES: DESCRIBE NEW BT'S WITNESS OBJECTS ETC. ESTABLISHED, OR WORK DONE TO PRESERVE EXISTING EVIDENCE

A 13" dia Red Fir bears S79°E 48.4 ft dist marked: 1/4 S2 BT.

A 10" dia Red Fir bears S27°W 9.5 ft dist marked: 1/4 S2 BT.

Blaze faces and 6" band around bearing trees are painted red. Trees tagged with 54-3 and 4 signs. New BTs have a lower blaze, scribed BT, with a brass washer stamped PLS 1106 nailed flush.

Work Done By W.R. Wells Title Surveyor Date 10/21/82 State Registration No. PLS 1106  
or Agency

Certified Cor. Record Prepared? Yes  No  Filed At: Umatilla County Surveyor Office Date \_\_\_\_\_

REMARKS

Witnessed by: Leslie E. Wilson