


Index  
File No. A-23  
T 4S R. 31E  
Merid. Willamette

CORNER RECORD (SEARCH)

Tract or  
Survey No. 5-47 Cor. No. A-23

R.D. Ukiah County Umatilla  
N.F. Umatilla State Oregon

CORNER DIAGRAM

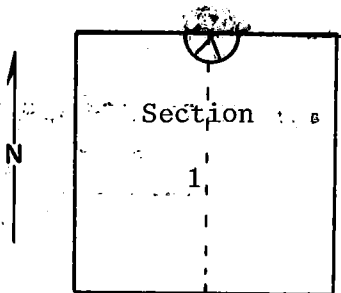

DESCRIBE CORNER MONUMENT FOUND

Markings: None.

DESCRIBE BEARING TREES OR OTHER OFFICIAL ACCESSORIES FOUND

A 30-inch p.pine stump (very rotten) blazed on NW face. "B.T." visible by opening blaze. There is evidence of an old east-west fence (old wire) through approximate location of  $\frac{1}{4}$  corner. B.T. stump will soon be gone.

PHOTO IDENTIFICATION DATA

Photo No. \_\_\_\_\_  
Filed At. \_\_\_\_\_  
Object Ident. \_\_\_\_\_  
Ident. By \_\_\_\_\_  
*Signature*

DESCRIBE CORNER LOCATION RELATIVE TO NEAR-BY FEATURES, ALSO HOW TO REACH CORNER

B.T. stump is 400 or 500 feet, approximately south, from cabin. Cabin is at end of primitive road. See Carney Butte 7.5 minute quadrant map.

PLANE COORDINATE POSITION DATA

State \_\_\_\_\_ Zone \_\_\_\_\_  
X \_\_\_\_\_  
Y \_\_\_\_\_  
Estab. By \_\_\_\_\_  
*Agency*

Signature  
T. Hollamon

Title  
Engineering Technician

Division  
S. O.

Headquarters  
Date  
November 15, 1974

7100-52  
REV. 65 5

CORNER RECORD (PERPETUATION)

MONUMENT. DESCRIBE NEW MONUMENT SET, OR WORK DONE TO PRESERVE EXISTING MONUMENT

9

ACCESSORIES : DESCRIBE NEW BT'S WITNESS OBJECTS ETC. ESTABLISHED, OR WORK DONE TO PRESERVE EXISTING EVIDENCE

I stuck 2 blank B.T. tags (back to back) in top of rotten B.T. stump. I also placed 2 location posters on a 14-inch snag topped white fir which stands against the west edge of B.T. stump. (Posters are on east and west sides of tree.)

10

Work Done By \_\_\_\_\_ Title \_\_\_\_\_ Date \_\_\_\_\_ State Registration No. or Agency \_\_\_\_\_

Certified Cor. Record Prepared ? Yes No Filed At: \_\_\_\_\_ Date \_\_\_\_\_

11

REMARKS

This  $\frac{1}{4}$  corner is common to Section 1, T4S, R31E only.

12

Index File No. T. R. M. Tract or Surv. No. Cor. 13