

U. S. Department of Agriculture
FOREST SERVICE

Umatilla NATIONAL FOREST

CORNERS OF THE PUBLIC SURVEY

T. 4S R. 31E Will. Mer.

1/4 Corner common to Sections
5, —, —, and —

Corner consists of a Stone () in place
State condition Good

Dimensions above ground 10 x 10 x 12 inches.

Sketch grooves, letters, figures, or notches, on proper face or edge.

CARDINAL POSITION				DIAGONAL POSITION			
							<u>1/4</u>
N	W	S	E	NW	SW	SE	NE

Mound of None is located

Pits are located None

Sketch markings of Bearing Trees (or Rocks) in proper box and fill blanks below, giving bearings from Corner to Trees and Distances in Links.

<u>1/4 S</u>	<u>None</u>	<u>None</u>	<u>None</u>
<u>Grown over</u>			

Species D.F. Wind Fall

Diameter 30"

Bearing _____

Distance _____


Do you believe this to be a genuine Land Office Corner? yes

If not, why? _____

8/11/53 (Date) A J Warren (Signature)
For Adm TM (Title)

T. _____ R. _____ Mer.

(Make sketch of topography near Corner and show section line markers thus "X")

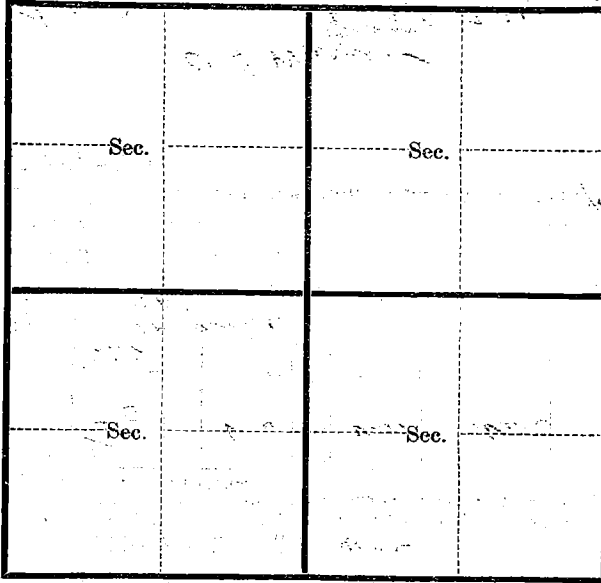

Metal Location Poster is on a _____
tree _____ inches diameter, on the _____
side of _____ from which
this Corner bears _____
(Bearing) _____ (Distance) Chains.

Section line marker between Secs. _____ and _____ is on
a _____ on the _____
(Tree, post, etc.) (Name of road, trail, etc.)

located _____ chains E, W, N, S, from Sec. Cor.; ¼ Cor.; Witness Cor.
(Cross out nonapplicable)

Give any further facts needed to find Corner again:

USDA-FOREST SERVICE

Index
File No. A-7

CORNER RECORD (SEARCH)

(Ref. FSM 7151.4)

Tract or
Survey No. _____
Cor. No. A-7


T 4S R. 31 E

R.D. Ukiah County _____

Merid. Willamette

N.F. Umatilla State Oregon

CORNER DIAGRAM

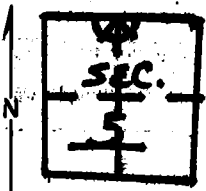

DESCRIBE CORNER MONUMENT FOUND

Material: None Size: None
Height Above Ground: none Condition: none
Skid road destroyed stone.

DESCRIBE BEARING TREES OR OTHER OFFICIAL ACCESSORIES FOUND

Down, very rotten fir; 30" dia. with blaze up scribed: /4
FS Attention poster on it.
There is a 10" fir 3' NE of bearing tree with FS location
poster on north side dated: 8/28/57 Riper.
Fence cor. NE approximately 200' dist from bearing tree with
fence south and East.

PRIORITY ONE

DESCRIBE CORNER LOCATION RELATIVE TO NEAR-BY FEATURES, ALSO HOW TO REACH CORNER

PHOTO IDENTIFICATION DATA

Photo No. _____
Filed At. _____
Object Ident. _____
Ident. By _____

Signature

PLANE COORDINATE POSITION DATA

State _____ Zone _____
X _____
Y _____
Estab. By _____

Agency

Signature
Mora

Title _____ (Division) _____ Headquarters _____
Eng. Tech.

Date
10/76

7100-52-(3/68)

CORNER RECORD (PERPETUATION)

MONUMENT: DESCRIBE NEW MONUMENT SET, OR WORK DONE TO PRESERVE EXISTING MONUMENT

ACCESSORIES : DESCRIBE NEW BT's WITNESS OBJECTS ETC. ESTABLISHED, OR WORK DONE TO PRESERVE EXISTING EVIDENCE

Work Done By _____ Title _____ Date _____ State Registration No. _____
 or Agency _____

Certified Cor. Record Prepared? Yes No Filed At: _____ Date _____

REMARKS

Index File No. T. R. M. Tract or Surv. No. Cor.