


CERTIFIED RECORD OF LAND CORNER MONUMENTATION

R - 3
DIAGRAM

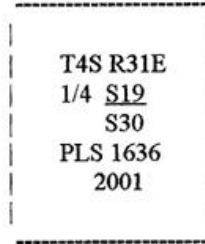

History of original corner establishment:

The original corner was established by George S. Pershin on October 29, 1880, under GLO contract No. 373, as follows:

Set a basalt stone, 14" x 12" x 10", in a mound of stones on a slight east slope for the 1/4 section corner.

Corner evidence recovered:

Found the original corner stone firmly set on the south edge of a mound of stones. The corner stone is 13" x 13" x 11" and is marked "1/4" on the south face.


Monument and accessories established to perpetuate the original position of this corner:

In place of the corner stone, I set a 1" x 30" galvanized iron pipe 18" into the ground. A 2 1/2" brass cap attached to the top of the pipe is marked as shown in the diagram above. I bury the corner stone along the south side of the pipe and build a mound of stones around the pipe, from which:

- A 18" Ponderosa Pine, scribed "1/4 S19 BT", bears N4° E, 64.4 feet. This tree has a "Bearing Object" sign nailed above the blazes.
- A 15" Ponderosa Pine, scribed "1/4 S30 BT", bears S54° E, 27.3 feet.
- A 15" Ponderosa Pine, scribed "1/4 S30 BT", bears S18° W, 94.3 feet.
- A 12" Ponderosa Pine, scribed "1/4 S19 BT", bears N65° W, 82.1 feet.

The new bearing trees are scribed on double blazes and have a 3/4" brass washer, marked "PLS 1636", nailed flush to the base of the lower blaze.

I hereby certify the above corner point was perpetuated as hereon described on June 21, 2001. Magnetic declination set in compass: 18° E.

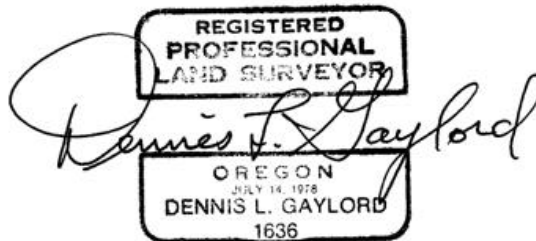

Renews June 30, 2003

Recorded at the office of County Surveyor, County of Umatilla, State of Oregon, on _____, 2001.

RECEIVED BY
 Umatilla County Surveyor
 Date 6-21
 Rec'd By KK
 No. 01-94-R