

OREGON CORNER RESTORATION FORM

Section 1 Township 5S Range 31E
 County Umatilla Date: 10-11-01

Corner Designation: 5S31A25

	Condition Report Only
x	Not Found
	Re monumented
x	Unrecorded
x	Surveyed In
x	Referenced Out


Previous Renewals / Surveys, etc.

Contract No. 373, Sept. 17, 1880.
 80.00 Set pine post, 5 ft. long, 6 ins. sa., on slight S. slope and dug pits & raised mound of earth, for Cor. to Tps. 4 & 5 S., Rs. 31 & 32 E., W. M. A pine, 12 ins. diam., brs. N77°W., 235 lks. dist. No other trees near.


Monument and Accessories Found: (condition and source)

Found a 42 inch Ponderosa Pine with split top, N77°W, 155.1' from corner point.

DIAGRAM

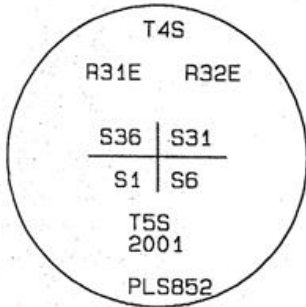

SKETCH

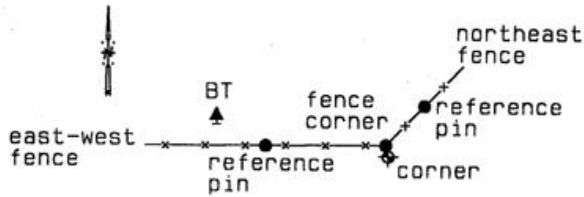

MONUMENT (S) AND ACCESSORIES SET (Procedures and Description)

Set a 1.25" x 30" galvanized iron pipe with 2.5" brass cap stamped as shown in the diagram. Set at record bearing and distance from the found bearing tree.

REFERENCES SET:

Set three 5/8" x 24" iron rebars with red plastic caps stamped ORLS 0852 and WAL5 13922. References set as shown in sketch; N85°02'W, 108.42' under fence line. N12°09'W, 10.28' at fence corner. N35°30'E, 54.76' under fence line.

Made GPS tie to TRI Station FORE.	Oregon State Plane Coord. - North Zone
Latitude 45°10'12.56493"N	Northing 552209.83
Longitude 118°54'03.58205"W	Easting 8614439.97
NAD 83 (1991)	Ortho Height 3603.84
	Ellipsoidal Height 3544.42

Location and Comments

From junction Highways 395 and 244, go east on Highway 244 1 mile to junction county road 1466, follow county road north 1 mile and east 0.5 mile. Walk north 1.0 mile to corner.

Compass Declination
20°E

Surveyors Seal

REGISTERED
 PROFESSIONAL
 LAND SURVEYOR

RECEIVED BY:

Date: 01-02
 Rec'd By: KE
 No. 02-05-R

Firm / Agency

Haddock Surveying
 P. O. Box 1574
 Pendleton, OR 97801
 (541) 276-2174

David L. Haddock

OREGON
 JULY 12, 1968
 DAVID L. HADDOCK
 852