

USDA-FOREST SERVICE

Index
File No. G-8


CORNER RECORD (SEARCH)

(Ref. FSM 7151.4)

Tract or
Survey No. _____ Cor.
No. CE1/16

T 4S R. 32E R.D. Ukiah County Umatilla
Merid. W.M. N.F. Umatilla State Oregon

CORNER DIAGRAM

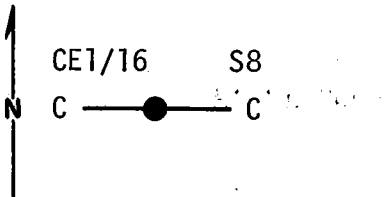

DESCRIBE CORNER MONUMENT FOUND

None Set.

DESCRIBE BEARING TREES OR OTHER OFFICIAL ACCESSORIES FOUND

None Set.

PHOTO IDENTIFICATION DATA

Photo No. _____
Filed At. _____
Object Ident. _____
Ident. By _____
Signature

DESCRIBE CORNER LOCATION RELATIVE TO NEAR-BY FEATURES, ALSO HOW TO REACH CORNER

The corner lies on a steep west slope about 300 feet west of a fire road.

PLANE COORDINATE POSITION DATA

State _____ Zone _____
X _____
Y _____
Estab. By _____
Agency

Barry B. Barbour

Signature Barry B. Barbour Title P.L.S. Division _____ Headquarters _____ Date 11/9/77 7100-52-(3/68)

CORNER RECORD (PERPETUATION)

GPO 902-673

MONUMENT: DESCRIBE NEW MONUMENT SET, OR WORK DONE TO PRESERVE EXISTING MONUMENT

Set 2½"x30" galvanized pipe with brass cap marked:
Set pipe 22" in ground and built a mound of stone to cap.

T4S R32E
CE1/16 S8
C —+— C
1977
OR PLS 1051

9

ACCESSORIES : DESCRIBE NEW BT'S WITNESS OBJECTS ETC. ESTABLISHED, OR WORK DONE TO PRESERVE EXISTING EVIDENCE

A Fir 7" in dia. bears N73°E, 4.8 ft., scribed CE1/16 S8 BT. A Fir 8" in dia. bears S75°W, 9:0 ft., scribed CE 1/16 S8 BT. Attached brass washer, stamped PLS 1051, to the foot blaze of each B.T. Attached a 54-3 and a 54-4 sign to each BT. Set a painted metal fence post 3 ft. east of the monument with a 54-2 and a 54-4 sign attached. Set another post 7 ft. south of the monument with a 54-2 and a 54-9 sign attached. Painted a 6" band around each BT and both blazes on each BT red.

10

Work Done By: Rodger Orton Title: Party Chief Date: 11/9/77 State Registration No. or Agency: _____

Certified Cor. Record Prepared? Yes No Filed At: _____ Date: _____

11

REMARKS

Witnesses to the above: G. Wagoner, L. Clemens

12

Index File No. T. R. M. Tract or Surv. No. Cor.

13