

USDA-FOREST SERVICE

Index File No. J-15

CORNER RECORD (SEARCH)

(Ref. FSM 7151.4)

Tract or Survey No. _____

Cor. No. 1/4


T 4S R. 32E

R.D. Ukiah County Umatilla

Merid. W.M.

N.F. Umatilla State Oregon

CORNER DIAGRAM

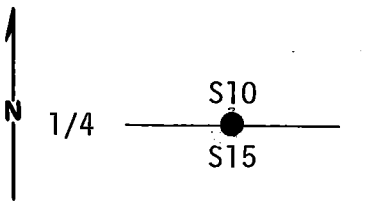

DESCRIBE CORNER MONUMENT FOUND

Original corner monument could not be found.
Has Been remonumented.

DESCRIBE BEARING TREES OR OTHER OFFICIAL ACCESSORIES FOUND

No trace of bearing trees.

PHOTO IDENTIFICATION DATA

Photo No. _____
Filed At. _____
Object Ident. _____
Ident. By _____
Signature

DESCRIBE CORNER LOCATION RELATIVE TO NEAR-BY FEATURES, ALSO HOW TO REACH CORNER

The corner is approximately two-thirds of the way down a steep west slope and is about 150 feet south of a fence and lies on the east edge of a large clearing.

PLANE COORDINATE POSITION DATA

State _____ Zone _____
X _____
Y _____
Estab. By _____
Agency

Barney B. Barber

Title Division Headquarters Date 7100-52-(3/68)

PLS

10/31/77

CORNER RECORD (PERPETUATION)

GPO 902-678

MONUMENT: DESCRIBE NEW MONUMENT SET, OR WORK DONE TO PRESERVE EXISTING MONUMENT

Set 2½" x 30" Galvanized pipe with brass cap marked:
Set pipe 20" in ground with mound of stones to cap.

T4S R32E
S10
1/4 —+—
S15
1977
OR PLS 1051

9

ACCESSORIES : DESCRIBE NEW BT'S WITNESS OBJECTS ETC. ESTABLISHED, OR WORK DONE TO PRESERVE EXISTING EVIDENCE

New BT's: 20" Pine bears N46°E, 86.0 ft., marked 1/4 S10 BT
18" Fir bears S24°W, 80.0 ft., marked 1/4 S15 BT
Placed 54-3 and 54-4 signs on both B.T's, also placed brass washer, stamped PLS 1051, in foot blaze of both trees. Painted a 6" red band and both blazes on both trees red. Set painted metal fence post 3 ft. north of monument w/54-4 sign.

10

Work Done By R.C. Orton Title Party Chief Date 10/31/77 State Registration No.
or Agency

Certified Cor. Record Prepared ? Yes No Filed At: Date

11

REMARKS

Witness to the above corner: G. Wagoner
L. Clemens

12

13